


PROPERTY SURVEY  
 SITUATED IN  
 LOT 2, PEPPER & TAYLOR SUBD'N.  
 D.L.C. NO. 40, T38S, RIW, W.M.  
 FOR  
 R.R. RETER  
 L. PLOVEJOY, L.S. MEDFORD, OREGON  
 SCALE: 1" = 50' JUNE 16, 1960

REGISTERED  
**OREGON**  
 LAND SURVEYOR  
*Leland P. Lovejoy*  
 NOVEMBER 18, 1949  
 LELAND P. LOVEJOY  
 262

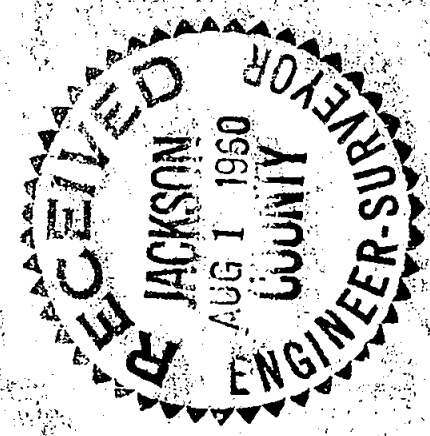

⊙ = SET 5/8" STEEL PIN  
 BEARINGS BY SOLAR  
 OBSERVATION

Survey Narrative to Comply with Section 87-3301947 Oregon State Laws

Survey for: R. R. Reter  
Reter Fruit Company  
Medford, Oregon

Purpose of Survey: To cut out piece of land and  
set property corners.

Survey Location: Lot 2, Pepper & Taylor Subdivision,  
D. L. C. No. 40, Township 38 South,  
Range 1 West, Willamette Meridian,  
Jackson County, Oregon

Survey Procedure: Found monuments and other survey  
points as shown on map and used for  
basis of survey control. Set 5/8"  
steel pins, as shown on map.

Leland P. Lovejoy  
Registered Land Surveyor  
Work completed June 16, 1960

