

Map of Survey

Located in the southeast quarter of Section 16  
Township 39 South, Range 1 East, of the Willamette  
Meridian, Jackson County, Oregon.

for:

**KEN PALEN**

2665 Alvarado Terrace South  
Salem, Oregon 97302

SURVEY NARRATIVE


Purpose: To survey and monument the North line of Tax Lot  
600, T39S-R1E-S16

Procedure: Utilizing found control work; done previously by  
this office under Kurt Weaver; a closed traverse  
was performed. The location of the property line  
was calculated and a monument was established as  
shown hereon.

LEGEND:

- Found monument as noted
- Set monument as noted

Meas. = measurement  
SN = survey number  
Sec. = section

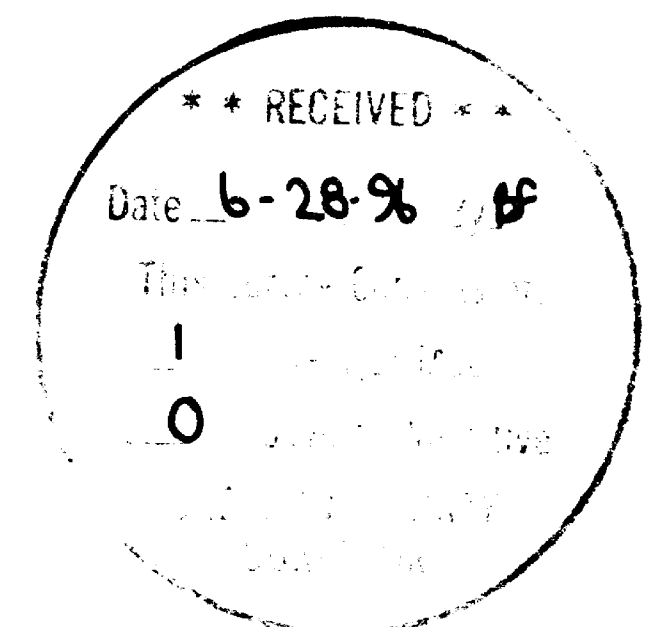

REGISTERED  
PROFESSIONAL  
LAND SURVEYOR

*Herbert A. Farber*  
OREGON  
JULY 26, 1985  
HERBERT A. FARBER  
2189

RENEWAL DATE 12-31-97

SURVEYED BY: FARBER & SONS, INC.  
FARBER SURVEYING  
P.O. BOX 5286  
CENTRAL POINT, OREGON 97502

OFFICE:  
908 EAST JACKSON  
MEDFORD, OREGON 97504  
PHONE: (503) 776-0846

COMPUTED BY: HAF  
SCALE: 1 inch : 100 feet  
DATE: 25 JUN 1996

ROTATION: 0°  
ORIGIN: 9890.000 N 7250.000 E  
JOB No.: 0580-96