


6051


1507

Survey For  
**MAURICE ROSSI**  
 Located in Sec. 30, T. 35 S., R. 1 E., W.M.  
 By: **Mark E. Boyden**  
 Aug, 1960

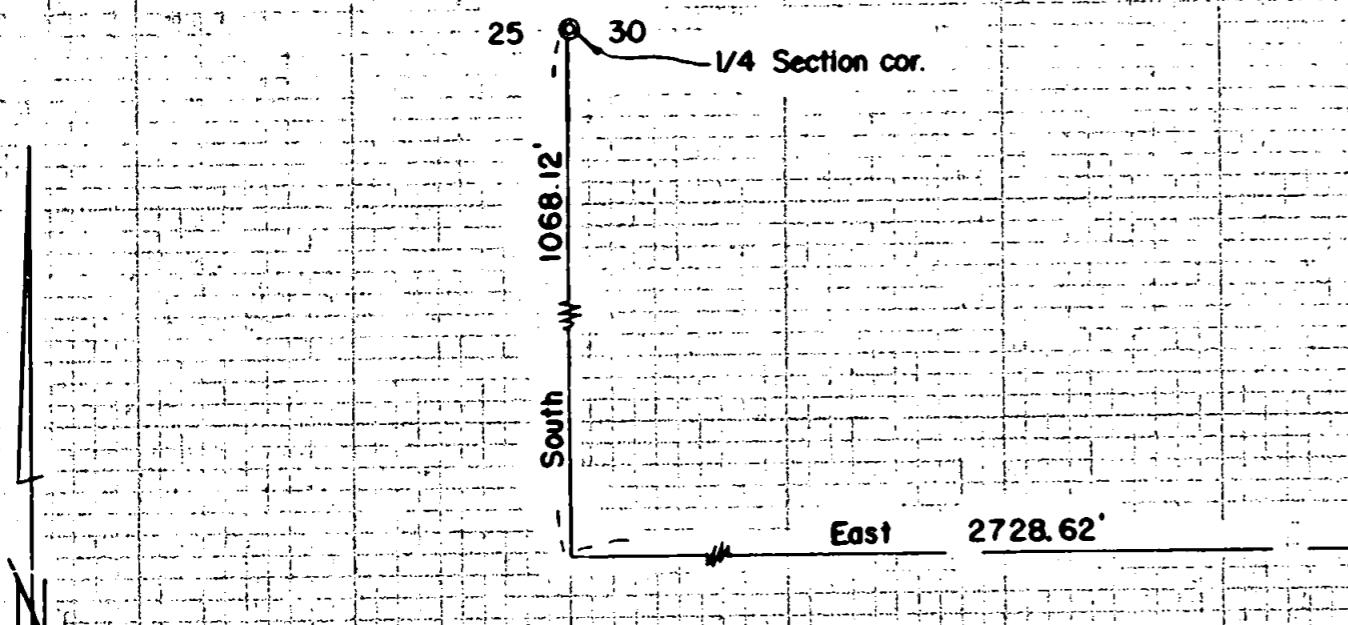


SCALE : 1"=100'

- Set 5/8" iron pin

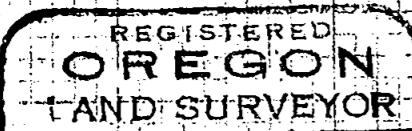

*Mark E. Boyden*  
 NOVEMBER 9, 1951  
**MARK E. BOYDEN**  
 281

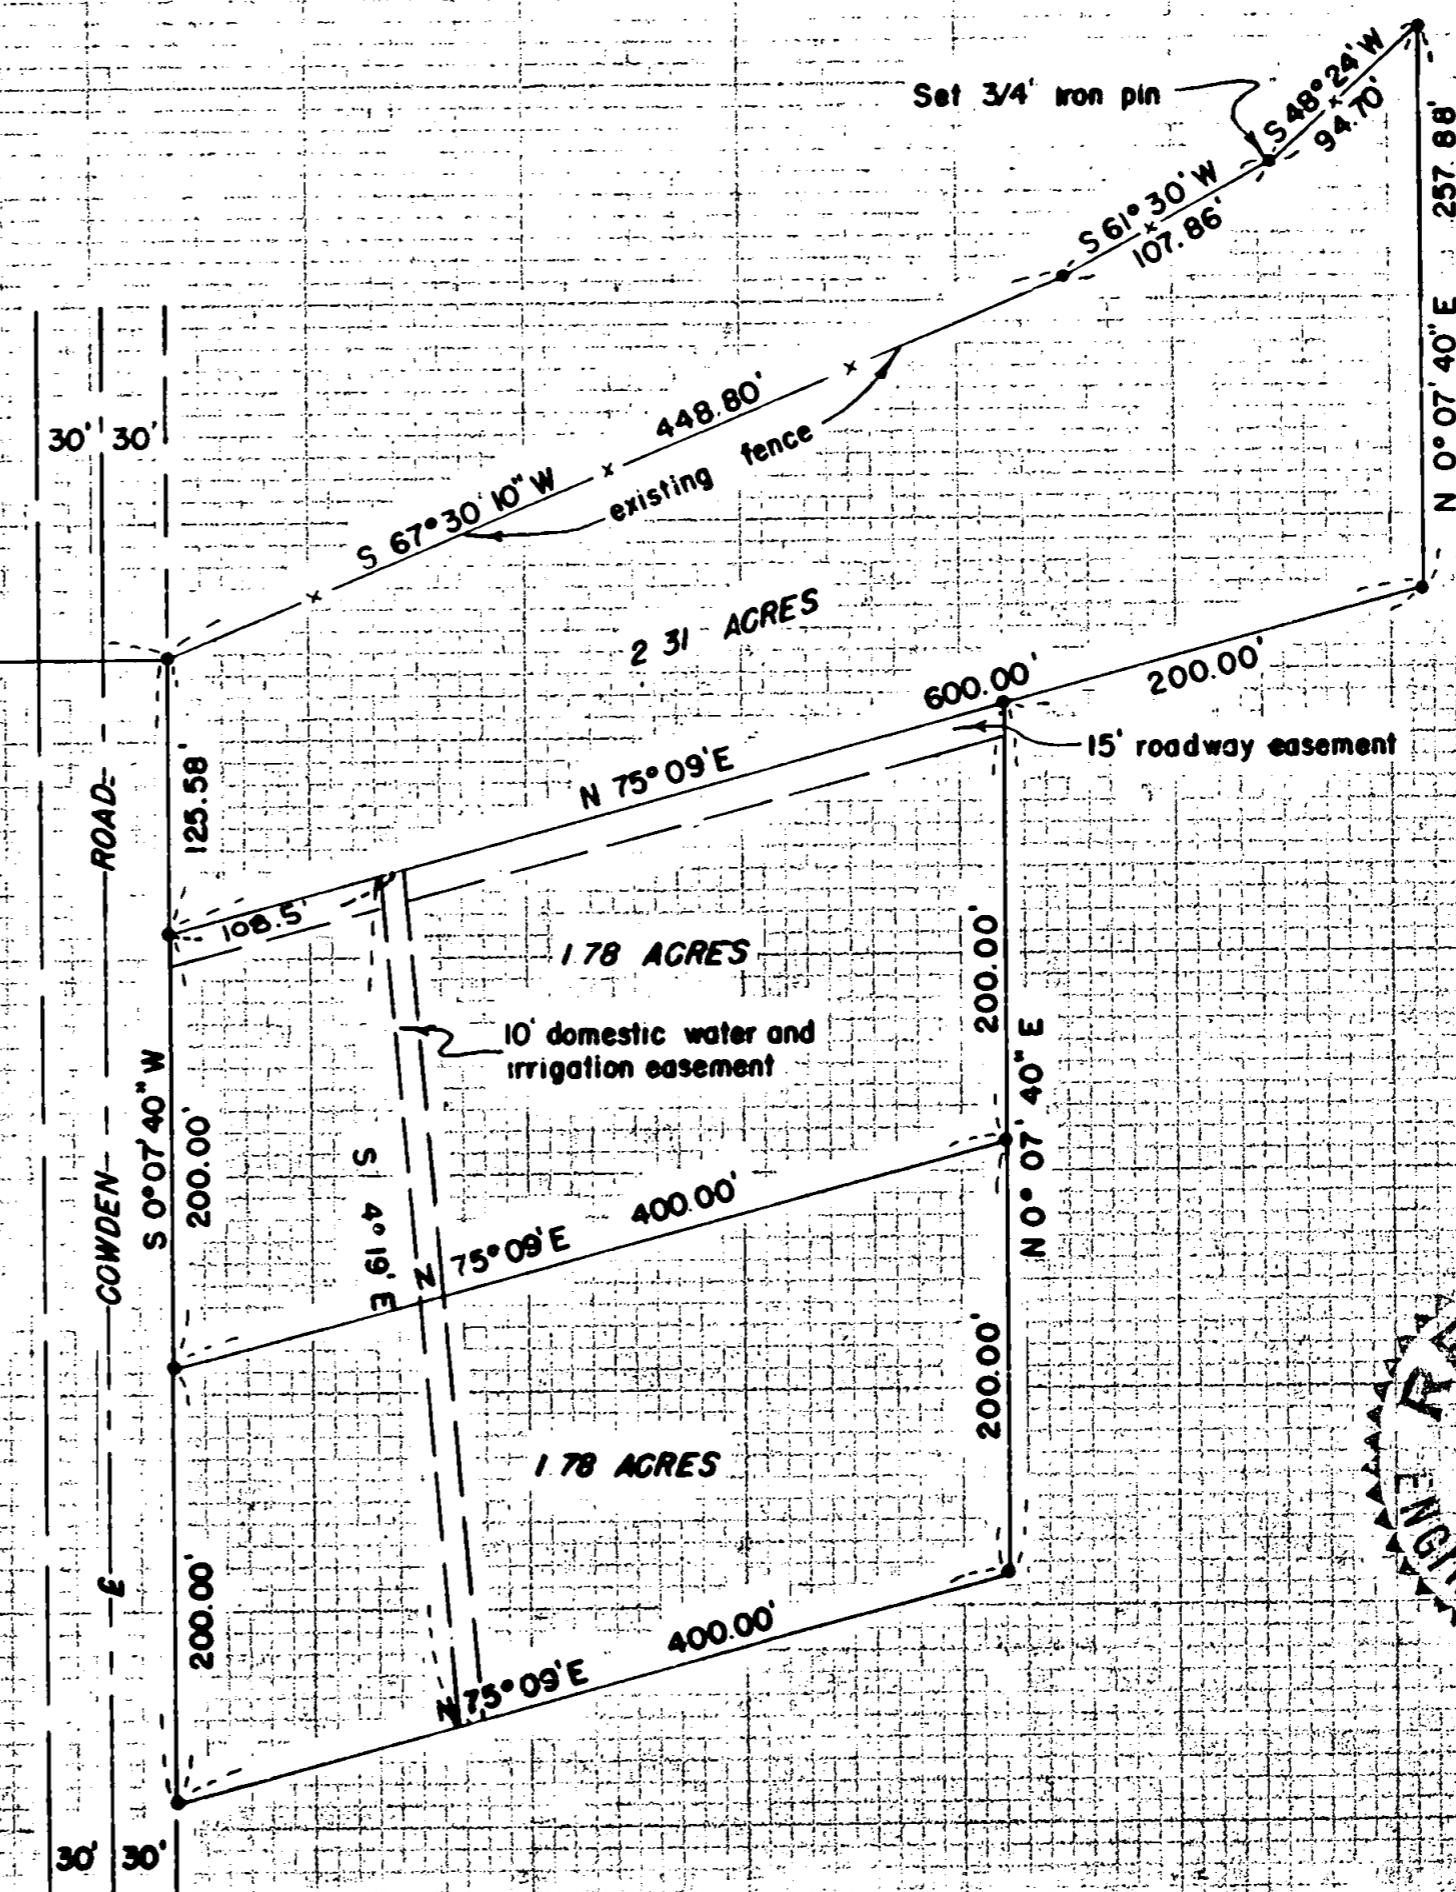

*JACKSON COUNTY ENGINEER-SURVEYOR*  
 JACKSON COUNTY  
 AUG 8 1950

1051

1507

SURVEY NARRATIVE TO COMPLY WITH PARAGRAPH 209.250,  
OREGON REVISED STATUTES

FOR: MAURICE ROSSI

- PURPOSE:
1. To monument and describe an agreement boundary between the Hamann and Rossi properties, so that with a quitclaim deed exchange, this boundary will be fixed according to this survey.
  2. To monument and describe three parcels in the Northwest corner of the Rossi ownership in Section 30, Township 35 South, Range 1, East.

PROCEDURE:

Found Cowden Road control points previously set by this office (See Recorded Survey No. 1046). From said controls, monumented the parcels as shown, using the existing fence line between the Hamann and Rossi properties to control the monumented agreement line.

August, 1960

