


SOURCES:  
 DEED RECORDS AS NOTED  
 PLAT BY J. WHITE 8-20-1949  
 MERIDEAN FROM RECORD

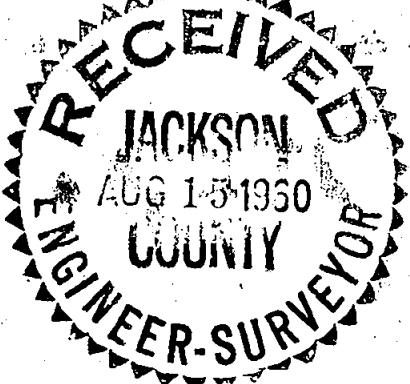

H. M. WICKS	
DATE 12 April 1960	REGISTERED OREGON LAND SURVEYOR <i>Lee B. Coon</i> 4-12-60
SEC. 21 TWP. 36 S. RGE. 4 W.	
SCALE 1" = 100 ft.	MAY 2, 1958 LEE B. COON 439
DRAWN BY LBC	
COUNTY Jackson	
<b>LEE B. COON, SURVEYOR</b> GRANTS PASS, OREGON	

LEE B. COON  
REGISTERED SURVEYOR  
PHONE OR 9-2360

POST OFFICE BOX 451      GRANTS PASS, OREGON

12 April, 1960

SURVEY FOR H. M. WICKS  
LOT SEVEN, RIVERDALE TRACTS  
S.21, T.36 S., R.4.W., W.M.

PURPOSE:

To delineate the boundaries of those tracts described in Vol. 322, P. 177 and Vol. 334, P. 199 deed records of Jackson County, Oregon, and to provide descriptions for two adjoining tracts.

PRIOR SURVEYS:

The Plat of Riverdale Tracts as recorded by John White of 8-20-1949.

CONTROL:

The found 3/4" Pipes at the NE. and SE. corner were connected by a traverse.

A 3/4" pipe found 168.3 ft. S.0° 20' E. of the NE. corner had apparently been RUN OVER by a car. I set a 2"X 2"X 10" hub W. 0.42 and S. 0.40 from this pipe, said hub being on line between Lots 7 and 8, and 168.7 ft. South from the NE. corner.

MERIDEAN:

The Record bearing for E. boundary of Lot 7.

