

15099

**SURVEY FOR:**

Kent & Gemma Maria-Johnson  
1616 Alta Vista Road  
Eagle Point, Oregon 97524

**LOCATION:**

SW 1/4 of Section II  
T.36S.,R.1W., W.M.,  
Jackson County, Oregon

**SURVEY BY:**

Kaiser Surveying  
19440 Highway 62  
Eagle Point, Oregon 97524

**DATE :**

AUGUST 28, 1996

**LEGEND**

- Found Monument as Indicated
- Set 5/8" x 24" Rebar with plastic cap marked "KAISER RLS 803"

( ) - Record Per S.N. 2705

S.N. - Filed Survey Number  
County Surveyors Office

\*\* RECEIVED \*\*

Date 9-10-96 By JK


This survey Consists of:

1 sheet(s) Map

1 page(s) Narrative

JACKSON COUNTY  
SURVEYOR

TL. No. 361W 1C - 600

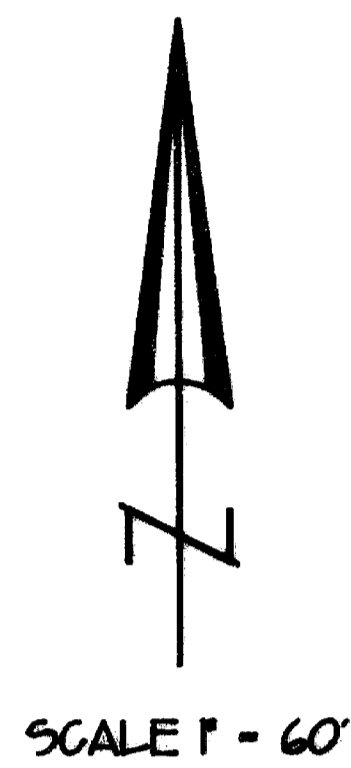


REGISTERED  
**PROFESSIONAL**  
LAND SURVEYOR

*JK*

OREGON  
JULY 16, 1987  
GARY D. KAISER  
NO. 308

EXP 6-30-97

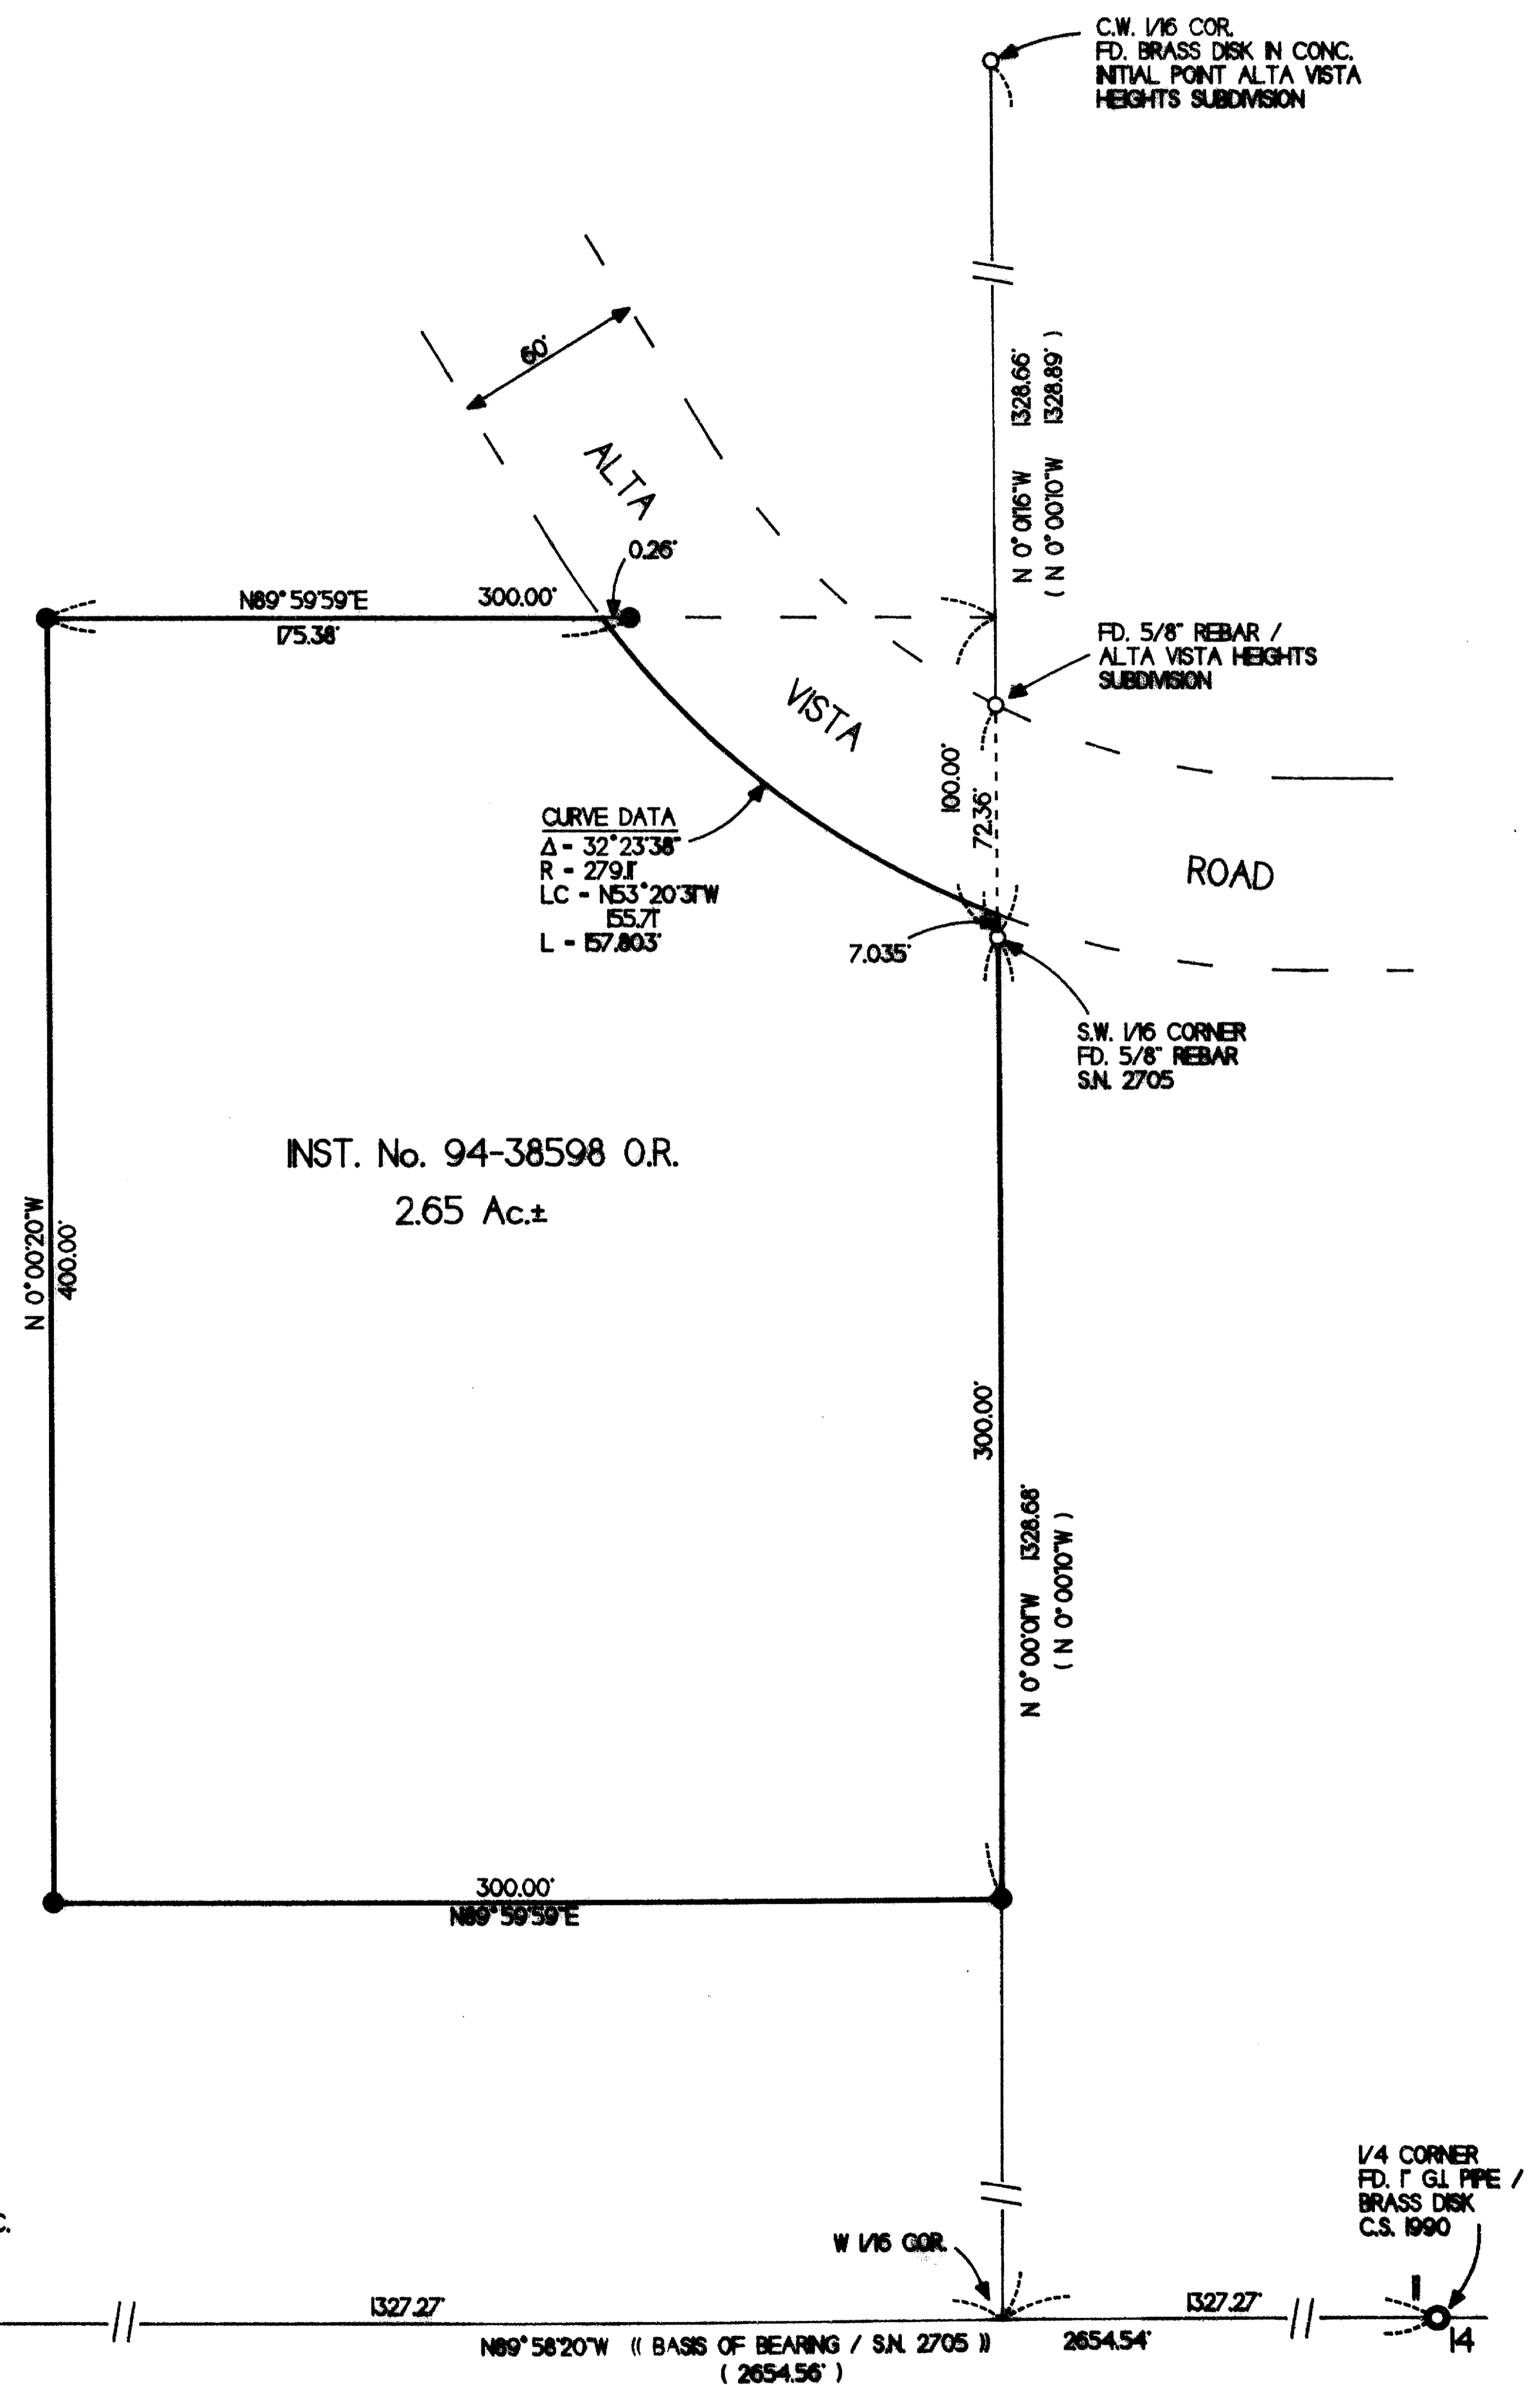

15099