


Revised 5-2-60

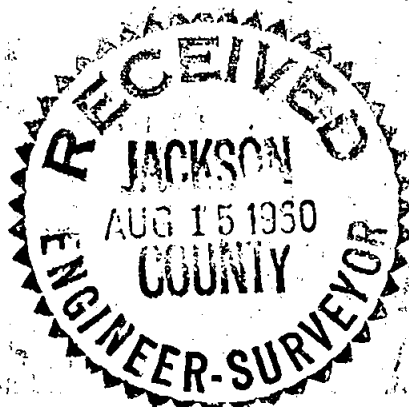

W.W. OWINGS	
DATE 12 APRIL 1960	REGISTERED OREGON LAND SURVEYOR <i>Lee B. Coon</i> 4-12-60
SEC. 15 TWP 34S RGE 4 W	
SCALE 1" = 100 ft	MAY 2 1960 LEE B. COON 438
DRAWN BY L.B.C.	
COUNTY JACKSON	LEE B. COON, SURVEYOR GRANTS PASS, OREGON

LEE B. COON
REGISTERED SURVEYOR
PHONE GR 9-2360

POST OFFICE BOX 451 GRANTS PASS, OREGON

SURVEY IN SECTION 15, T.34 S., R.4 W., W.M.

PURPOSE:

To provide a survey for record of two adjoining tracts in Section 15.

PRIOR SURVEYS:

The B.L.M. SUBDIVISION of Section 1958
The B.P.R. FOREST ACCESS ROAD 1959?

CONTROL:

The center of section, a 2½ inch iron pipe with brass cap marked;

C ¼ S 15
T 34 S R4 W
1958

The Center-East 1/16 corner, a 2½ in. I.P. with brass cap mkd.,

E 1/16
c c
S 15
1958

The B.P.R. R/W markers, # 5 rebars with painted 2"x 4" stks. set alongside, mkd.,

30
These are set at all P.C.'s and P.T.'s of new allinment.

PROCEDURE:

The int'sect. of the E-W center-line and the Westerly R/W line of the road was straddled in and monumented. The distance was measured East to the 1/16 cor. The R/W was surveyed from point to point, solving for curve data from field measurements. The road is in the process of being reallined and construction has not yet began.

