

NOTE: THE 1/4 CORNER COMMON TO SECTIONS 4 AND 9, BEARS NORTH, 1286.65' AND WEST, 1828.62'

**CURVE DATA**

(A)	(B)
R - 60.00	R - 60.00
Δ - 45°26'08"	Δ - 42°30'14"
L - 47.58	L - 44.51
LC BRG - S 43°45'04" E	LC BRG - S 01°20'53" E
LC - 46.34	LC - 43.50

(C)
R - 40.00
Δ - 110°29'42"
L - 77.14
LC BRG - S 01°22'09" E
LC - 65.73

**LEGEND**

- ⊕ SET 5/8" X 30" REBAR WITH YELLOW PLASTIC CAP MARKED "TEMPLIN LS2359"
  - ▲ INDICATES CALCULATED POSITION
  - FOUND 5/8" IRON ROD PER FILED SURVEY NUMBER 2763
  - FOUND 5/8" IRON ROD PER FILED SURVEY NUMBER 6576
  - (( )) RECORD BEARING/DISTANCE PER FS 6576
  - INDICATES OLD PROPERTY LINE
  - INDICATES ADJUSTED PROPERTY LINES
- BEARINGS BASED UPON FILED SURVEY NUMBER 6576, AS SHOWN.


**SURVEY NARRATIVE**

**PURPOSE:** To survey and mark the adjusted lines, per Jackson County Staff report 96-287 PA, as depicted on the map.

**PROCEDURE:** Tied the 1/4 corner common to Sections 4 and 9 and monuments set on filed survey 2793 and 6576. I computed the adjusted line and set monuments, as shown. New legal descriptions were created for the adjusted Tax Lots and deeds were recorded.

APPROVED THIS 19<sup>th</sup> DAY OF September, 1996.

*Dick Converse, Planner III*  
JACKSON COUNTY PLANNING

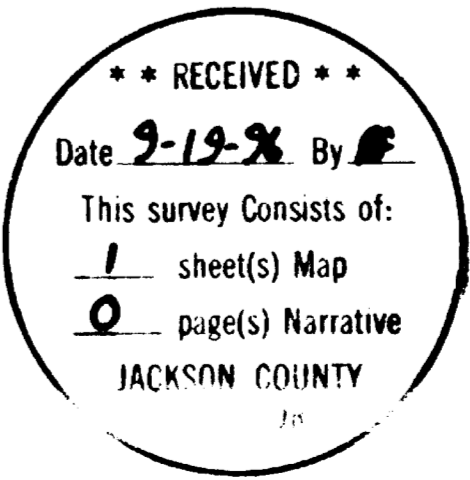

JACKSON COUNTY PLANNING FILE NUMBER 96-287 PA

**REGISTERED PROFESSIONAL LAND SURVEYOR**  
RICHARD J. TEMPLIN  
2200 CRESTON COURT  
MEDFORD, OR 97504

**MAP OF SURVEY**  
LOCATED IN  
THE NE 1/4 OF SECTION 6, T.37N, R.12E, W.1E  
JACKSON COUNTY, OREGON  
SURVEYED FOR H.D. LOONEY  
DATE SEPTEMBER 13, 1996