


RECORD BEARINGS USED
 ○ = SET 5/8" STEEL PINS

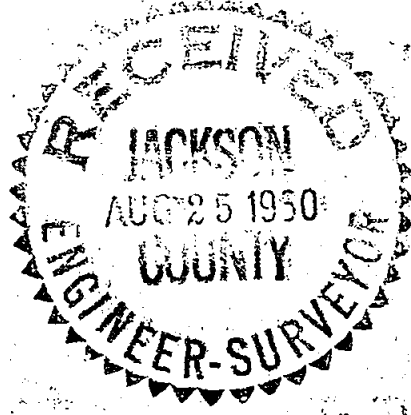

REGISTERED
OREGON
 LAND SURVEYOR

Leland P. Lovejoy

NOVEMBER 18, 1949
 LELAND P. LOVEJOY
 262

BOUNDARY SURVEY
 SITUATED IN
 D.L.C. #60, T37S, R2W, WM.
 JACKSON COUNTY, OREGON
 FOR
 W.G. ROBINSON

L.P. LOVEJOY, LAND SURVEYOR
 MEDFORD, OREGON
 SCALE: 1"=100' AUG. 1, 1960

Survey Narrative to Comply with Section 87-330

1947 Oregon State Laws

Survey for: W. G. Robinson
Table Rock Road
Medford, Oregon

Purpose of Survey: To establish property boundaries.

Survey Location: D. L. C. No. 60, T 37 S., R 2 W.,
W. M., Jackson County, Oregon

Survey Procedure: Found monuments and other survey
points and used these as basis for
survey control. Set property corners
as shown on map.

Leland P. Lovejoy
Registered Land Surveyor
Work completed August 1, 1960

