

C/L EAST MAIN STREET

MAP OF SURVEY
For
PETER and PHOEBE NOYES

Located in:

Lot 6 of Block 4 of SISKIYOU HEIGHTS ADDITION in the N.W. 1/4
of Section 29, T.37S., R.1W., W.M.
City of Medford, Jackson County, Oregon

HOFFBUHR & ASSOCIATES, INC.
1062 E. JACKSON STREET MEDFORD, OREGON
(541)779-4641
BY: DOUGLAS C. McMAHAN PLS No. 1913
SCALE: 1" = 60' February 21, 1997
BASIS OF BEARING: SISKIYOU HEIGHTS ADDITION (WEST BOUNDARY OF BLOCK 4)

- = Set 5/8" x 24" Iron pin with plastic cap stamped "D. McMahan LS 1913".
- = Found 3/4" Iron pipe per SISKIYOU HEIGHTS ADDITION according to the Official Plat thereof; now of record in Jackson County, Oregon
- S/N = Survey Number
- J.C.D.R. = Jackson County Deed Records



** RECEIVED **
Date 2-21-97 By DCM
This survey consists of:
1 sheet(s) Map
1 page(s) Narrative
JACKSON COUNTY
SURVEYOR

REGISTERED
PROFESSIONAL
LAND SURVEYOR
Douglas C. McMahan
OREGON
DIT # 1913
DOUGLAS C. McMAHAN
No. 1913
Expires 12/31/98

15297

SURVEY NO. _____

**SURVEY NARRATIVE TO COMPLY WITH PARAGRAPH 209.250
OREGON REVISED STATUTES**

Survey for: Peter & Phoebe Noyes
20 South Barneburg
Medford, Oregon 97504



Location: Lot 6 of Block 4 of Siskiyou Heights Addition in
the Northwest One-Quarter (1/4) of Section 29,
Township 37 South, Range 1 West, Willamette Meridi-
an, City of Medford, Jackson County, Oregon

Purpose: To survey and monument the Southerly boundary of
the tract described in Instrument No. 89-08182 of
Jackson County Deed Records.


Procedure: Utilizing found monumentation per plat of Siskiyou
Heights Addition to the City of Medford for con-
trol, I established monuments as shown on the
accompanying map. A Wild T-2000 electronic total
station was used to make measurements in the field.
Note on map the location of chainlink fence which
lies 5' - 6' North of monumented line.

Basis of
Bearing: Siskiyou Heights Addition (West boundary of Block 4)

Date: February 17, 1997

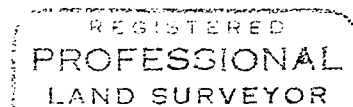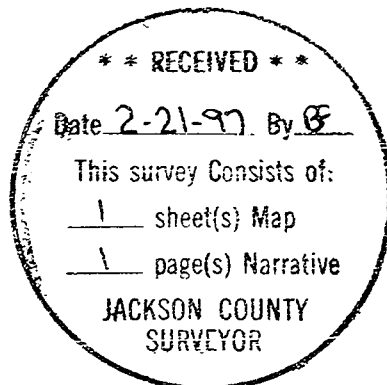

Douglas C. McMahan

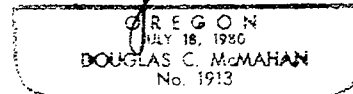

Douglas C. McMahan
L.S. 1913 - Oregon
Expires 12/31/98
Hoffbuhr & Associates, Inc.
1062 East Jackson Street
Medford, Oregon 97504