

T39S, R1E
12
7 R2E
Fd. 2" Pipe w/CS br. disc.



SCALE 1" = 100'
Basis of Bearings R.S. No. 7182

LEGEND
 ○ = 5/8" x 24" Pin (tagged P.L.S. No. 638)
 ● = Found 5/8" Pin per R.S. No. 7182, unless noted otherwise
 ○ = Found 5/8" Pin per R.S. No. 13010
 O.R.J.C.O. = Official Records Jackson County Oregon

APPROVAL:
Carol Parker
 JACKSON COUNTY PLANNING
 File No. 93-15-LLA
 9-21-93
 DATE

RECEIVED
 Date 3-21-97 By
 This survey consists of:
 1 sheet(s) Map
 1 page(s) Narrative
 JACKSON COUNTY SURVEYOR

REGISTERED
 PROFESSIONAL
 LAND SURVEYOR
George Burrell
 OREGON
 E.S.
 Exp. 12/31/93

MAP OF SURVEY
 Of Lot Line Adjustment located in the NE
 1/4 of Section 12, Twp 39 South, Range 1 East
 For: JAMES C. MILLER
 By: George Burrell, P.L.S., 1379 Brookdale Rd.
 Medford, OR 97504, 96920, 1993

SURVEY NARRATIVE TO COMPLY WITH O.R.S. 209.250

FOR:

James Miller
975 Dead Indian Memorial Rd.
Ashland, Oregon 97520

LOCATION:

The Northeast 1/4 of Section 12, Township 39 South, Range 1 East

PURPOSE:



To monument and describe a lot line adjustment for tax lots no. 100,305,108 and 109-39-1E-12 according to the clients instructions and conditions of County Planning approval.

PROCEEDURE:

The monuments of Recorded Surveys 7182, 13010 and previous survey control monuments for said surveys, were recovered and used as control for locating and monumenting the lot line adjustments according to the clients instructions and County Planning approval.

BY:

George Burrell, P.L.S.
1379 Brookdale Rd.
Medford, Oregon 97504
Sept. 20, 1993

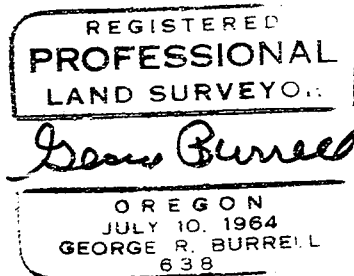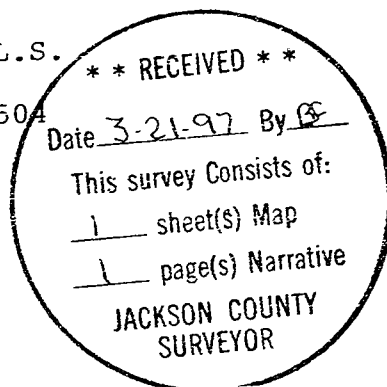

Exp. 12/31/93

T.L. No. 100,305,108 and 109-39-1E-12