

APPROVAL

Examined and approved this 23 day of June, 1997.

By: Dorothy Saylor
Jackson County Planning Department (File 96-365-PA)

MAP OF SURVEY

PROPERTY LINE ADJUSTMENT
In Blocks 5 & 6 of MEADOW GLADE SUBDIVISION &
being a portion of the Southeast 1/4 of Section 34,
T.37 S., R.2 W., W.M., Jackson County, Oregon
(JCDPD File # 96-365-PA)

SURVEY FOR:

DARLEEN RIPPETOE
502 West Main Street
Medford, OR 97501

SURVEY BY:

L.J. Friar & Assoc., P.C.
Consulting Land Surveyors
816 West Eighth Street
Medford, OR 97501
(541) 772-2782

LEGEND:

- - Fd. 1" iron pipe per MEADOW GLADE SUBDIVISION.
 - o - Set 5/8" x 24" iron pin w/ plastic cap mkd. L.J.FRIAR & ASSOC.
- ORJCO - Official Records of Jackson County, Oregon. () - Plat record data.


BASIS OF BEARINGS: MEADOW GLADE SUBDIVISION as shown.

DATE: April 15, 1997 UNIT OF MEASUREMENT: Feet SCALE: 1"=60'

SURVEY NARRATIVE TO COMPLY WITH O.R.S. 209.250.

PURPOSE: To survey and monument the adjusted property lines and prepare legal descriptions for the adjusted Taxlots. See Jackson County File No. 96-365-PA.

PROCEDURE: Made ties to found monuments per MEADOW GLADE SUBDIVISION and to the centerline of Griffin Creek. Calculated the POSITIONS OF THE ADJUSTED Taxlot corners and set same. Those monuments found as well as those set are as shown hereon.

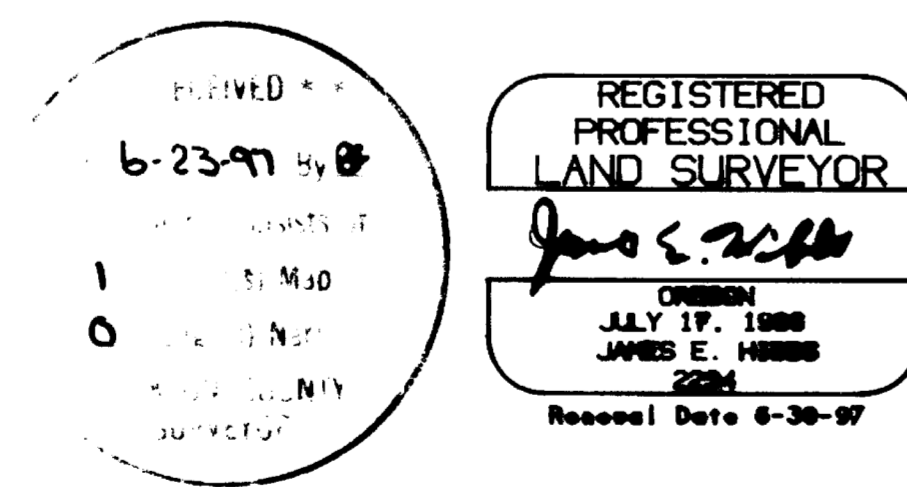

N

