

1542

SURVEY For:


ELK LUMBER CO.

Located in Sec. 32, T.32S. R.3E.

and Sec. 5, T.33S. R.3E.


By: Mark E. Boyden

Sept. 1960

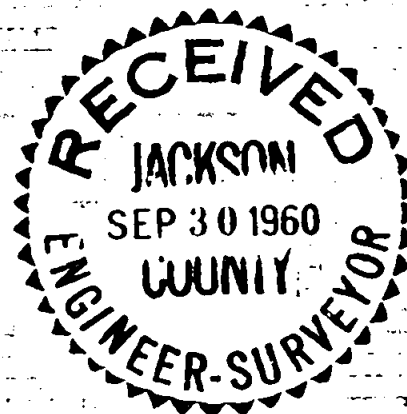

SCALE: 1" = 600'

○ Set 1" x 36" I. Pipe with 2-1/2" bronze cap

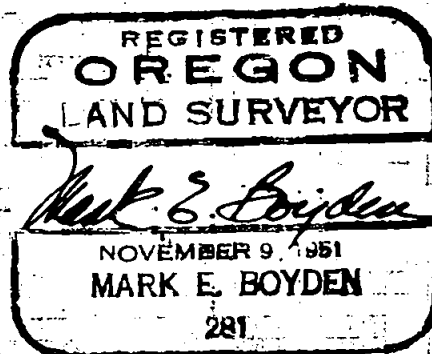

West 1/16 Sec. Cor.
Set 3/4" x 36" I. Pipe

1542

SURVEY NARRATIVE TO COMPLY WITH PARAGRAPH 209.250
Oregon Revised Statutes

FOR: ELK LUMBER CO.

PURPOSE: To monument corners between Section 32, Township 32 South, Range 3 East, and Section 5, Township 33 South, Range 3 East as shown on the map to accompany this report.

PROCEDURE: Traversed with transit and chain from the Southwest to the Southeast corner of said Section 32. For more detailed information regarding the establishment of the Government corners on the South boundary of Section 32, see the re-establishment records, County Surveyors Office.

At the West one-sixteenth section corner between Sections 32 and 5, set a 3/4" x 45" galvanized iron pipe for corner from which:

a 10" Fir, single blazed bears North 80° West,
5.4 feet;

a 5" Cedar, single blazed bears North 1° West,
5.4 feet;

Sept. 1960

