15479

Map of Survey

Located in the northeast quarter of Section 20, Township 37 South, Range 2 West of the Willamette Meridian, Jackson County, Oregon.
for

Patricia Cook

3583 Ross Lane
Central Point, Oregon 97502

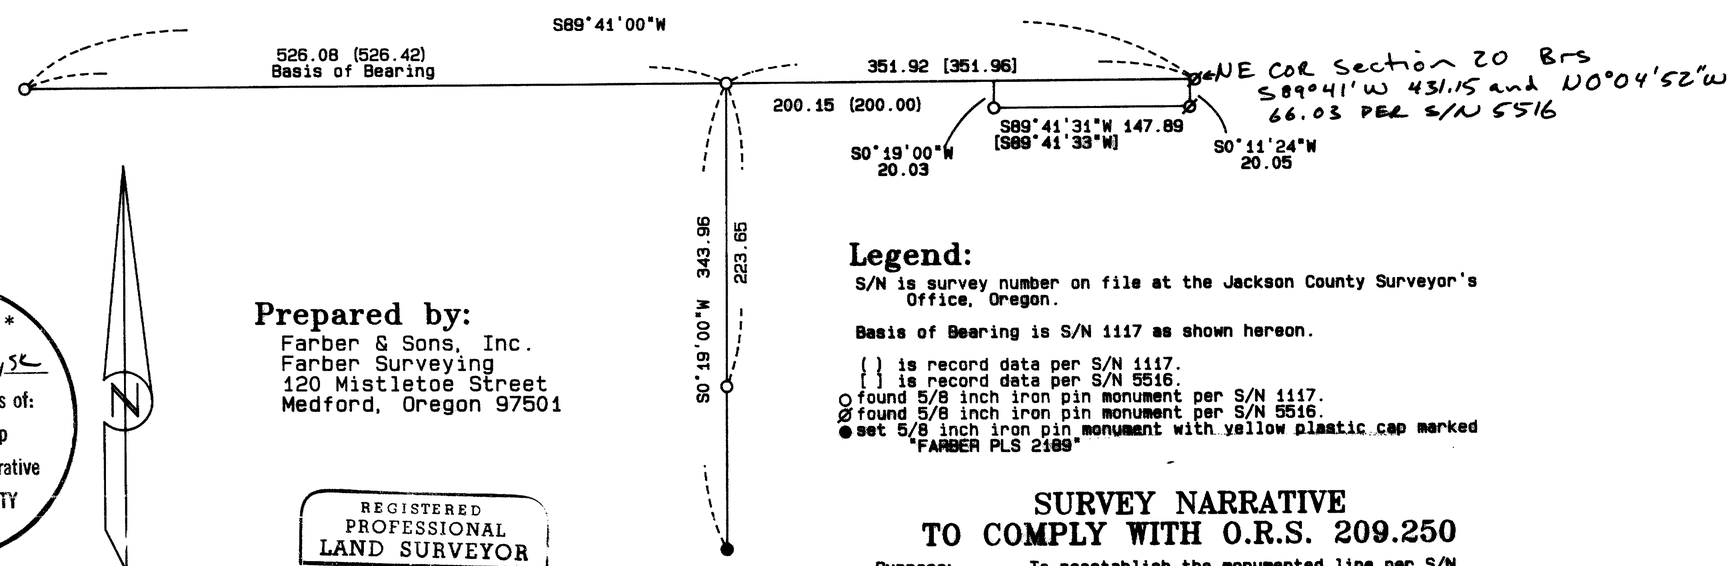

* * RECEIVED * *
Date 8/20/97 By SK
This survey Consists of:
1 sheet(s) Map
0 page(s) Narrative
JACKSON COUNTY SURVEYOR

1"=100'
August 4, 1997

Prepared by:
Farber & Sons, Inc.
Farber Surveying
120 Mistletoe Street
Medford, Oregon 97501

REGISTERED PROFESSIONAL LAND SURVEYOR
OREGON
JULY 26, 1985
HERBERT A. FARBER
2189

RENEWAL DATE 12-31-97

Legend:

S/N is survey number on file at the Jackson County Surveyor's Office, Oregon.

Basis of Bearing is S/N 1117 as shown hereon.

( ) is record data per S/N 1117.
[ ] is record data per S/N 5516.
○ found 5/8 inch iron pin monument per S/N 1117.
⊘ found 5/8 inch iron pin monument per S/N 5516.
● set 5/8 inch iron pin monument with yellow plastic cap marked "FARBER PLS 2189"

SURVEY NARRATIVE TO COMPLY WITH O.R.S. 209.250

Purpose: To reestablish the monumented line per S/N 5516 as shown hereon.

Procedure: Utilizing Nikon Total Station and Sokkia Data Recorder, I tie the monuments as shown in a closed traverse. Monuments found were accepted as previously used. An additional monument was set along the subject line as shown per clients request.

ASSESSOR'S MAP No 37 2W 20 TL 601

15479