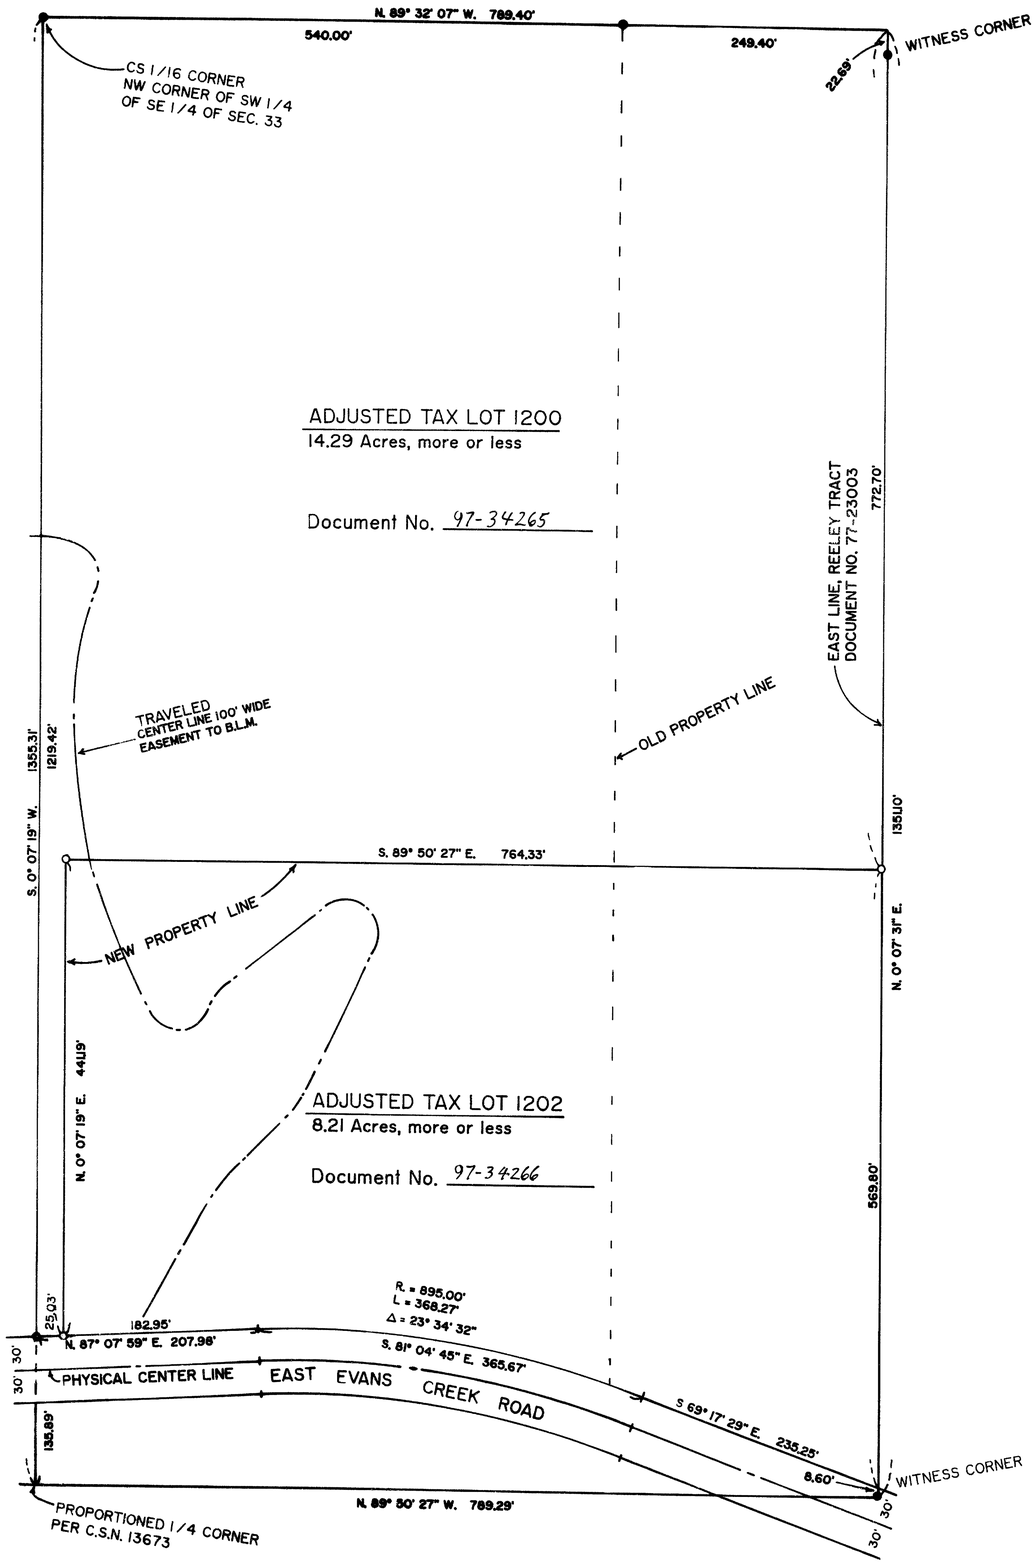

MAP OF SURVEY

Property Line Adjustment Located in the SE 1/4 of Section 33, T. 34 S., R. 3 W. of the Willamette Meridian, Jackson County, Oregon.

Date: July 14, 1997

SURVEY FOR: John & Esther Reeley
15005 East Evans Creek Road
Rogue River, OR 97537

SURVEY NARRATIVE TO COMPLY WITH CHAPTER 209, PARAGRAPH 250, OREGON REVISED STATUTES

PURPOSE: A property line adjustment survey of Tax Lots 1200 and 1202 making the property more useable. The old existing house being located on Adjusted Tax Lot 1200 and the existing mobile home on Adjusted Tax Lot 1202.

PROCEDURE: Found 5/8" steel pins set in County Survey No. 13673 as shown hereon. Used found steel pins and control points of prior survey for control to survey the new property lines and set the new property corners.

EQUIPMENT: Nikon NTD-4 Semi-automatic theodolite/E.D.M.

N

LEGEND

Scale: 1" =100'

C.S.N. = County Survey No.

Basis of Bearings: C.S.N. 13673

● Found 5/8" Steel Pin per C.S.N. 13673

o Set 5/8" x 24" Steel Pin w/plastic cap stamped "D.W. EDWARDS LS 741"

SURVEY BY: Darrel W. Edwards
Professional Land Surveyor
4520 Averill Drive
Grants Pass, OR 97526
Phone: 1 (541) 471-7059

REGISTERED PROFESSIONAL LAND SURVEYOR

Darrel W. Edwards

OREGON JULY 8, 1969 DARREL W. EDWARDS 741

EXPIRES 12/31/97

RECEIVED
Date 9-15-97 By
This survey consists of:
1 sheet(s) Map
0 page(s) Narrative
JACKSON COUNTY SURVEYOR

APPROVAL

Approved by the Jackson County Department of Planning and Development.

By Shirley Roberts Date 7-14-97
97-195-PA

T. 34-3W., 33, T.L.1200 & 1202