MAP OF SURVEY

PROPERTY LINE ADJUSTMENT
Of Lots 8 & 9, BRIARWOOD SUBDIVISION.
Located in the N.E. 1/4 of Sec. 28, T.37 S., R.1 W., W.M. City of Medford
Jackson County, Oregon

SURVEY NARRATIVE TO COMPLY WITH O.R.S. 209.250

PURPOSE: To survey and monument the adjusted Property Lines and prepare legals descriptions for use in recording new deeds.

PROCEDURE: From existing control and monuments set by this office during BRIARWOOD SUBDIVISION, set pins at the locations requested by the client. Prepared legal descriptions to be placed on deeds to be recorded. Those monuments found as well as those set are shown hereon.

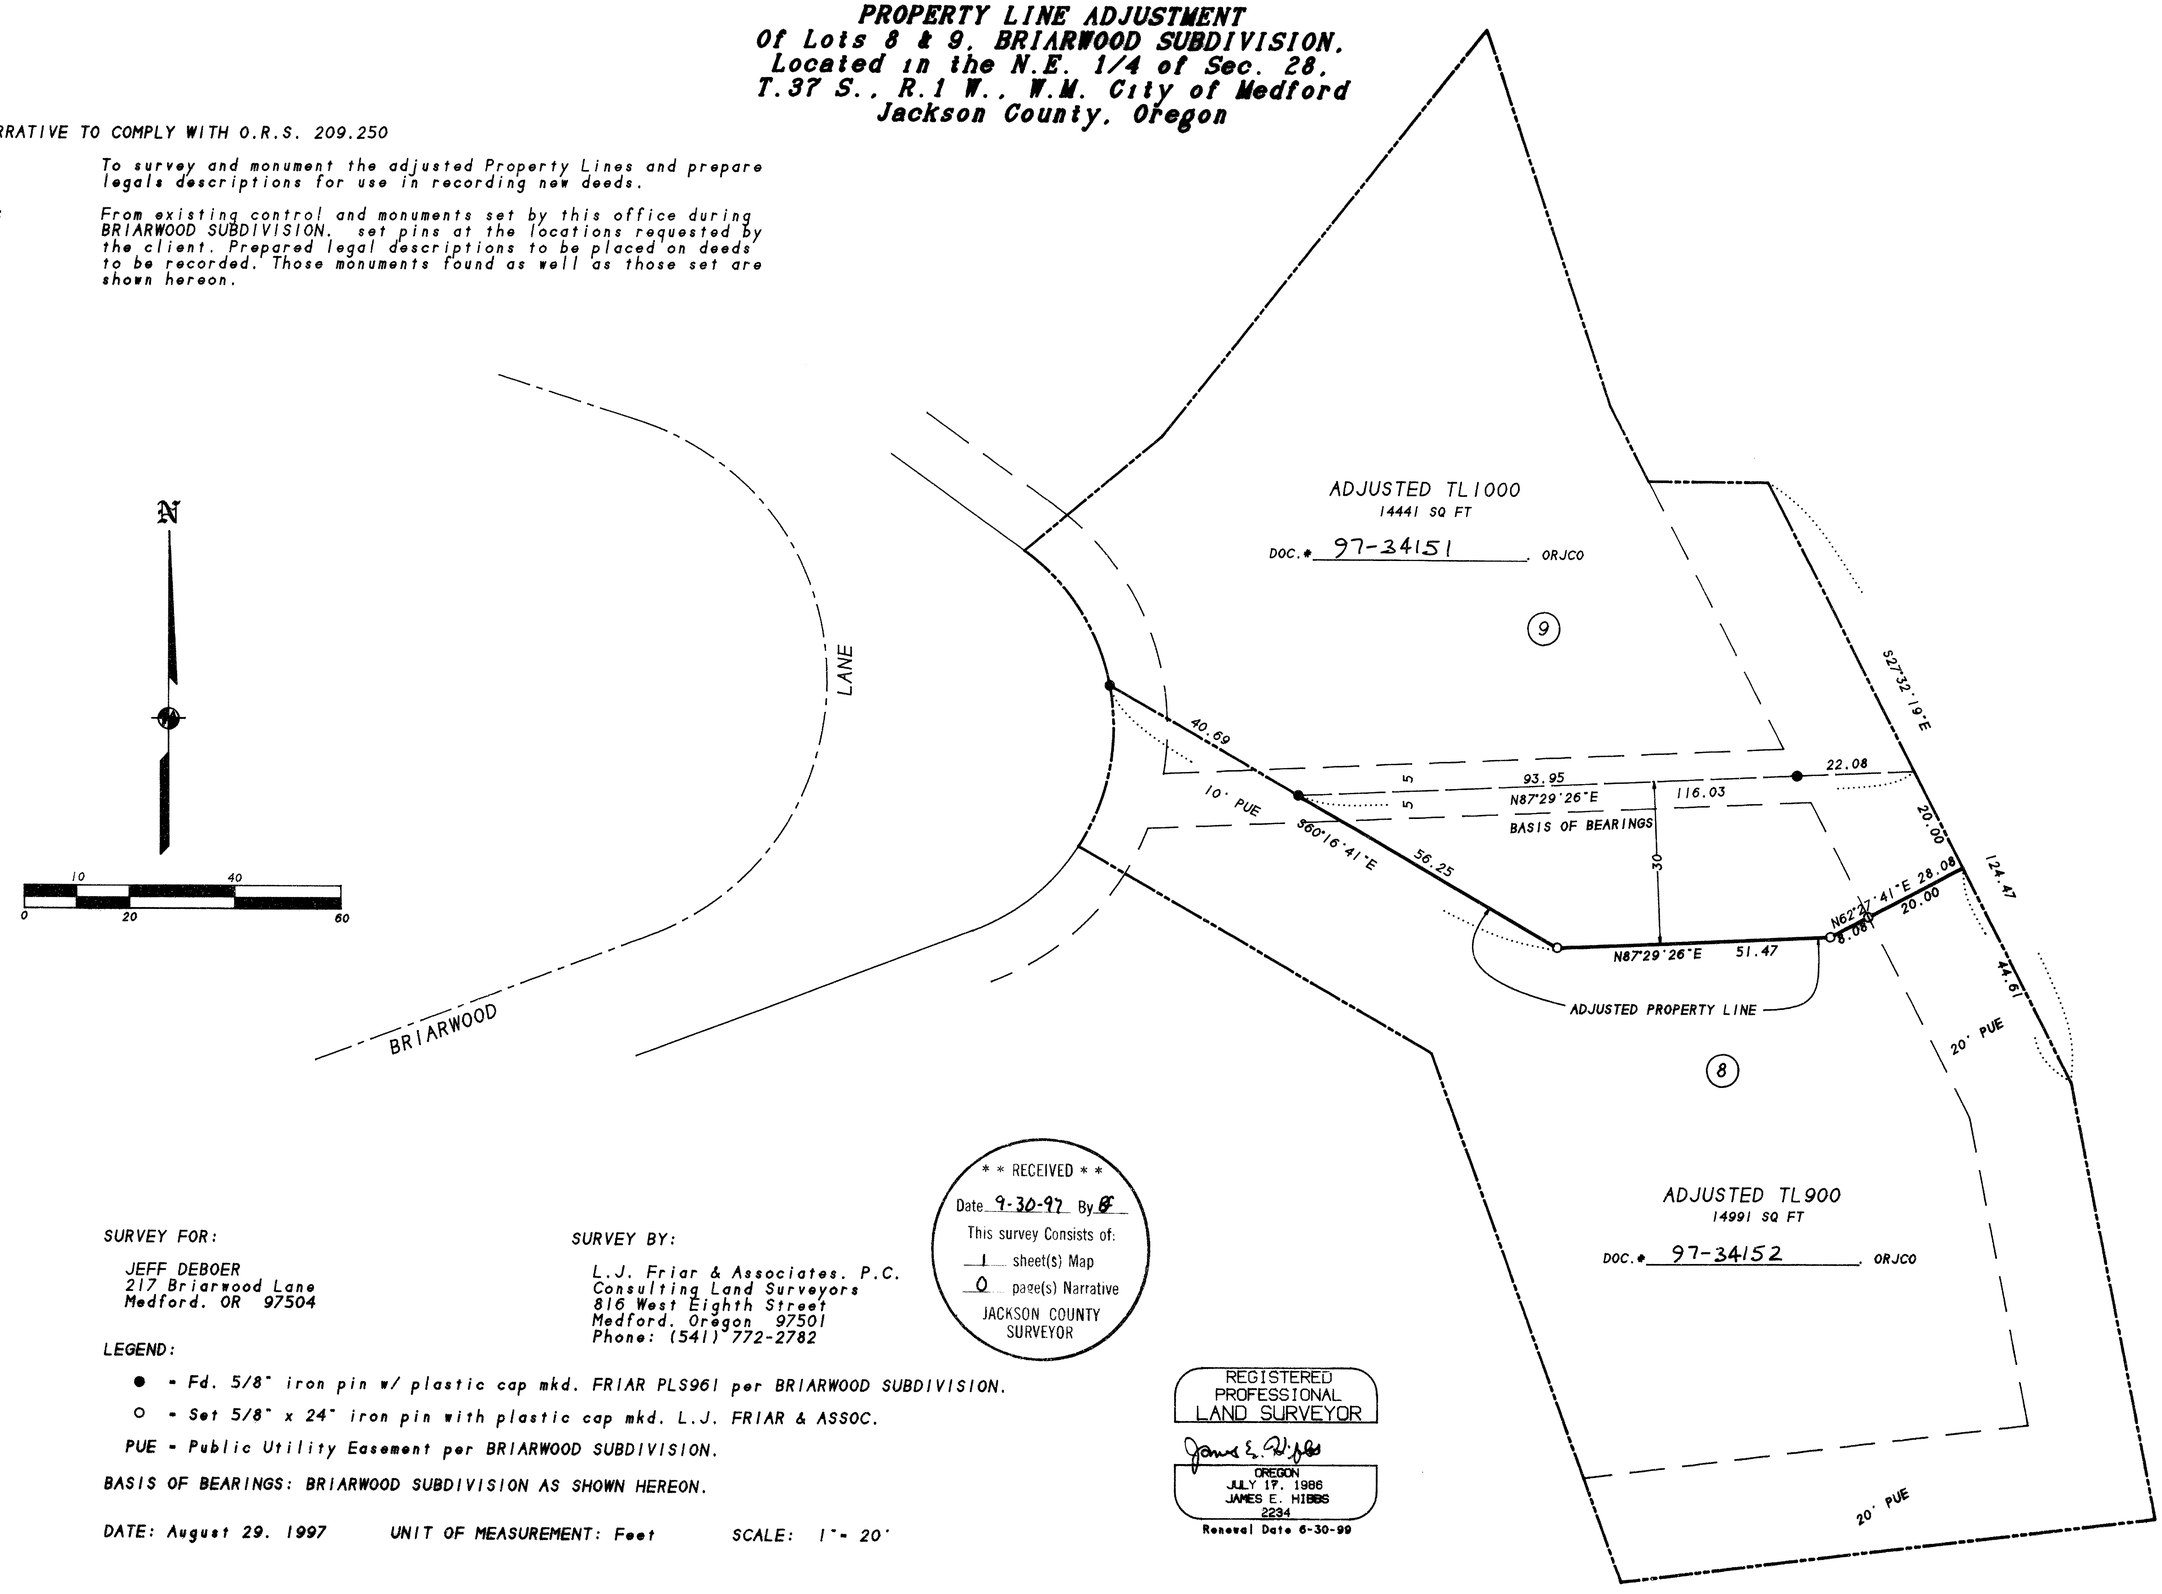

SURVEY FOR:

JEFF DEBOER
217 Briarwood Lane
Medford, OR 97504

SURVEY BY:

L.J. Friar & Associates, P.C.
Consulting Land Surveyors
816 West Eighth Street
Medford, Oregon 97501
Phone: (541) 772-2782

* * RECEIVED * *
Date 9-30-97 By
This survey Consists of:
1 sheet(s) Map
0 page(s) Narrative
JACKSON COUNTY SURVEYOR

LEGEND:

● - Fd. 5/8" iron pin w/ plastic cap mkd. FRIAR PLS961 per BRIARWOOD SUBDIVISION.

○ - Set 5/8" x 24" iron pin with plastic cap mkd. L.J. FRIAR & ASSOC.

PUE - Public Utility Easement per BRIARWOOD SUBDIVISION.

BASIS OF BEARINGS: BRIARWOOD SUBDIVISION AS SHOWN HEREON.

REGISTERED PROFESSIONAL LAND SURVEYOR
OREGON
JULY 17, 1986
JAMES E. HIBBS
2234
Renewal Date 6-30-99

DATE: August 29, 1997 UNIT OF MEASUREMENT: Feet SCALE: 1" = 20'

371W28AD TL'S 900 & 1000

97-259