

## RECORD OF SURVEY

LOCATED IN NE 1/4 & SE 1/4 OF SECTION 15,

AND IN NW 1/4 & SW 1/4 OF SECTION 14,
IN TOWNSHIP 38 SOUTH, RANGE 1 WEST OF THE WILLAMETTE MERIDIAN
IN JACKSON COUNTY, OREGON

N47°58'02"E

SCALE: 1" = 200'


OCTOBER 1997

This servey Consists of:

L shoots Non

page(s) Narrative

ACASON COUNTY
SURVEYOR

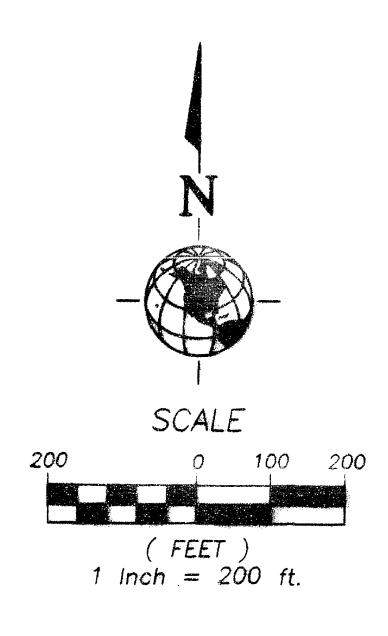

CENTER LINE INTERSTATE-5
FOUND 3" BRASS ODOT DISK
HIGHWAY MON. A PER SURVEY 5011
ODOT STA = 1084+75.82 P.O.T.
(HELD FOR LINE)

SURVEY NARRATIVE

THE PURPOSE OF THIS SURVEY IS TO MONUMENT THAT TRACT OF LAND OWNED BY OREGON DEPARTMENT OF TRANSPORTATION, DESCRIBED IN VOLUME 167, PAGE 379, CIRCUIT COURT CASE NO. 61-200-L.

THE NORTH LINE WAS ESTABLISHED BY HOLDING THE 3" BRASS DISK AT THE NORTHEAST CORNER OF DONATION LAND CLAIM (DLC) NO. 43 AND THE 3" BRASS DISK AT THE SOUTHEAST CORNER OF DLC NO. 42.

THE EAST LINE WAS ESTABLISHED BY RUNNING A LINE PARALLEL TO AND 959.97 FEET WESTERLY (PER DEED RECORDED IN BOOK 410, PAGE 392, RECORDED MAY 27, 1955) OF THE EAST LINE OF DLC NO. 43, WHICH WAS ESTABLISHED BY HOLDING THE 3" BRASS DISK AT THE NORTHEAST CORNER OF DLC NO. 43 AND A 3/4" BOLT CONCRETED IN A 6" CONCRETE TILE, AS SHOWN ON SURVEY 15023.

THE SOUTHWESTERLY AND NORTHEASTERLY LINES WERE ESTABLISHED BY OFFSETTING A LINE BETWEEN FOUND 3" BRASS DISKS ON THE CENTER LINE OF INTERSTATE NO. 5, 150.00 FEET AND 725.00 FEET NORTHEASTERLY, RESPECTIVELY, PER VOLUME 167, PAGE 379, CIRCUIT COURT CASE NO. 61-200-L.

THE SOUTH LINE WAS ESTABLISHED BY RUNNING DEED BEARING (ROTATED TO CENTER LINE OF INTERSTATE 5 AS BASIS) FROM POINT RESTABLISHED FROM FOUND WITNESS CORNERS PER SURVEY 15023.

BOUNDARY SURVEY FOR:
OREGON DEPARTMENT OF TRANSPORTATION
200 ANTELOPE ROAD
WHITE CITY, OREGON 97503

BASIS OF BEARING THE CENTER LINE OF INTERSTATE - 5 AS N 42'01'58" W PER SURVEY NO. 15023

TAX LOT DESIGNATION
TAX MAP 38 1W 15D
TAX LOT 100

REFERENCE SURVEYS:

SN 5643 SN 1891

SN 1036

4-3215-0101

SOCKRSO1 DWG

SN 1891 SN 15023 SN 5011 SN 8313 LEGEND:
FOUND MONUMENT AS NOTED

O SET 5/8" IRON ROD WITH YELLOW PLASTIC CAP MARKED "WASH PACIFIC"

IED

CENTER LINE INTERSTATE-5
FOUND 3" BRASS ODOT DISK
(HELD FOR LINE)

150.00'

FOUND 5/8" IRON ROD
S33721'18"E
0.46'

435.10'

435.10'

FOUND 3" BRASS ODOT DISK
TO A CONTROL OF THE CON

REGISTERED

PROFESSIONAL

LAND SURVEYOR

JERRY L. ANDERSON

RENEWAL: 12-31-97

SE COR. DLC #42 FOUND 3" BRASS DISK (HELD FOR NORTH LINE DLC #43) N89°57'16"E 338.48 591.20' 959.97 N.E. COR. DLC #43 FOUND 3" BRASS DISK-(HELD) VOLUME 167, PAGE 379 CIRCUIT COURT CASE NO. 61-200-L FOUND 2 1/2" BRASS DISK STAMPED "GPS" N47°58'02"E 81.16 FOUND 1/2" IRON ROD W/YPC N47'58'02"E 89.55 N89°54'15"E N89°54'15"E = 266.90'-762.72' 2 FOUND 5/8" IRON ROD W/ALUM CAP STAMPED "BOYDEN PLS 281" (HELD) 246.90 -*20.00*° N47°58'02"E 150.00' FOUND 5/8" IRON ROD W/ALUM CAP STAMPED "BOYDEN PLS 281" (HELD) POINT ON EAST LINE DLC #43 FOUND 1 1/4" BOLT IN ----6" CONCRÉTE PEDESTAL (HELD PER SURVEY NO. 15023)

SHEET 1 OF 1