

SURVEY NARRATIVE TO COMPLY WITH O.R.S. 209.250

LOCATION: SOUTHEAST QUARTER SECTION 6 TOWNSHIP 35
SOUTH RANGE 3 WEST WILLAMETTE MERIDIAN,
JACKSON COUNTY, OREGON.

SURVEY FOR: GILINSKY LOGGING COMPANY
P.O. BOX 1627
ROGUE RIVER, OREGON 97537

SURVEY BY: ARTHUR R. RAMBO LS1086
735 VISTA PARK DRIVE
EAGLE POINT, OREGON 97524

DATE: DECEMBER 22, 1997

BASIS OF BEARING: SURVEY NUMBER 6015 (EAST HALF OF SOUTH
LINE)

PURPOSE: TO MARK AND POST LINES FOR LOGGING
PURPOSES, FOR GILINSKY LOGGING CO. IN THE
SOUTHEAST QUARTER OF SAID SECTION 6, AS
SHOWN ON THE PLAT TO ACCOMPANY THIS
NARRATIVE.

PROCEDURE: A SEARCH OF RECORDS REVEALED THAT THE
EXTERIOR CORNERS OF SAID SECTION 6 NEEDED
FOR CONTROL OF THIS SURVEY WERE
RE-ESTABLISHED FROM ORIGINAL EVIDENCE OR
PROPORTIONATE MEASUREMENT. THE WEST
QUARTER CORNER OF SECTION 6 WAS SET BY
PROPORTIONATE MEASUREMENT ON SURVEY NUMBER
6015 IN 1975. THE ORIGINAL WEST QUARTER
SECTION CORNER WAS FOUND AND RE-
ESTABLISHED BY THE JACKSON COUNTY
SURVEYORS OFFICE IN 1987. I USED THE
POSITION AS RE-ESTABLISHED BY THE JACKSON
COUNTY SURVEYOR FOR CONTROL OF THIS
SURVEY. THE EAST QUARTER CORNER OF SECTION
6 WAS SET BY PROPORTIONATE MEASUREMENT ON
SURVEY NUMBER 3415. THIS POSITION WAS
REMONUMENTED ON SURVEY NUMBER 11995. THE
EAST QUARTER SECTION CORNER OF SECTION 6
WAS ALSO SET BY PROPORTIONATE MEASUREMENT
ON SURVEY NUMBER 6015. I FOUND THIS
MONUMENT BURIED 27 INCHES DEEP IN A GRAVEL
DRIVEWAY. THIS CORNER MORE CLOSELY FITS
THE ACTUAL PROPORTION POSITION FOR THE
CORNER, THEREFORE I USED THIS POSITION FOR
CONTROL ON THIS SURVEY.

I RAN A CLOSED TRAVERSE TYING TO THE
CORNERS NEEDED FOR CONTROL OF THIS SURVEY.

A POSITION FOR THE CENTER ONE-QUARTER
CORNER WAS CALCULATED. THE INTERIOR LINES
NEEDED WERE THEN RAN BEGINNING AND ENDING
ON THE EXTERIOR TRAVERSE OF SAID SECTION.

CORNERS SET THIS SURVEY

ALL MEASUREMENTS TO BEARING TREES ARE TO THE CENTER OF TREE AT BASE UNLESS OTHERWISE STATED. BEARING TREES HAVE A BRASS WASHER MARKED LS1086 NAILED TO LOWER FACE.

CENTER ONE-QUARTER CORNER SECTION 6 TOWNSHIP 35 SOUTH RANGE 3 WEST. AT THE INTERSECTION OF THE NORTH-SOUTH CENTERLINE AND THE EAST-WEST CENTERLINE OF SECTION 6, I SET A 5/8 BY 30 INCH REBAR WITH A 2 INCH DIAMETER ALUM. CAP EXPOSED FOUR INCHES MARKED:

T35S R3W
C1/4 + S6
PLS 1086



FROM WHICH:

A 5 INCH DIAMETER MADRONA BEARS S78° 03'E, 30.5 FEET MARKED C1/4S6 IN UPPER FACE, BT IN LOWER FACE.

A 5 1/2 INCH DIAMETER MADRONA BEARS N37° 01'E, 12.9 FEET MARKED C1/4S6 IN UPPER FACE, BT IN LOWER FACE.

A 7 1/2 INCH DIAMETER FIR BEARS N31° 26'W, 8.4 FEET MARKED C1/4S6 IN UPPER FACE, BT IN LOWER FACE.

A 6 1/2 INCH DIAMETER OAK BEARS S70° 01'W, 22.7 FEET MARKED C1/4S6 IN UPPER FACE, BT IN LOWER FACE.

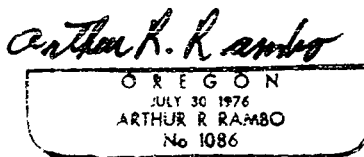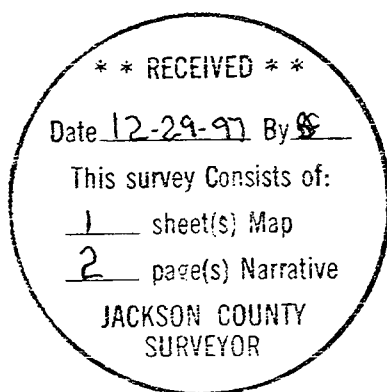

REGISTRATION EXPIRES DECEMBER 31, 1998

TAX LOT 35-3W-06-600