2.25

MAP OF SURVEY

PROPERTY LINE ADJUSTMENT

LOCATED in the SW 1/4 of Section 12, T. 38 S., R. 3 W., W.M., Jackson County, Oregon

February 25, 1998

SURVEYED BY: Eagle-Eye Surveying Corporation
23 North Ivy Street
Medford, Oregon 97501

P.O. Box 447

Jacksonville, Oregon 97530

SURVEYED FOR: Clarence R. Rouse


SURVEYOR

PROFESSIONAL
LAND SURVEYOR

OREGON
JULY 19, 1994
RUSSELL D BRAUGHTON
2657

Expires 12/31/99

Phone: (541) 776-2313

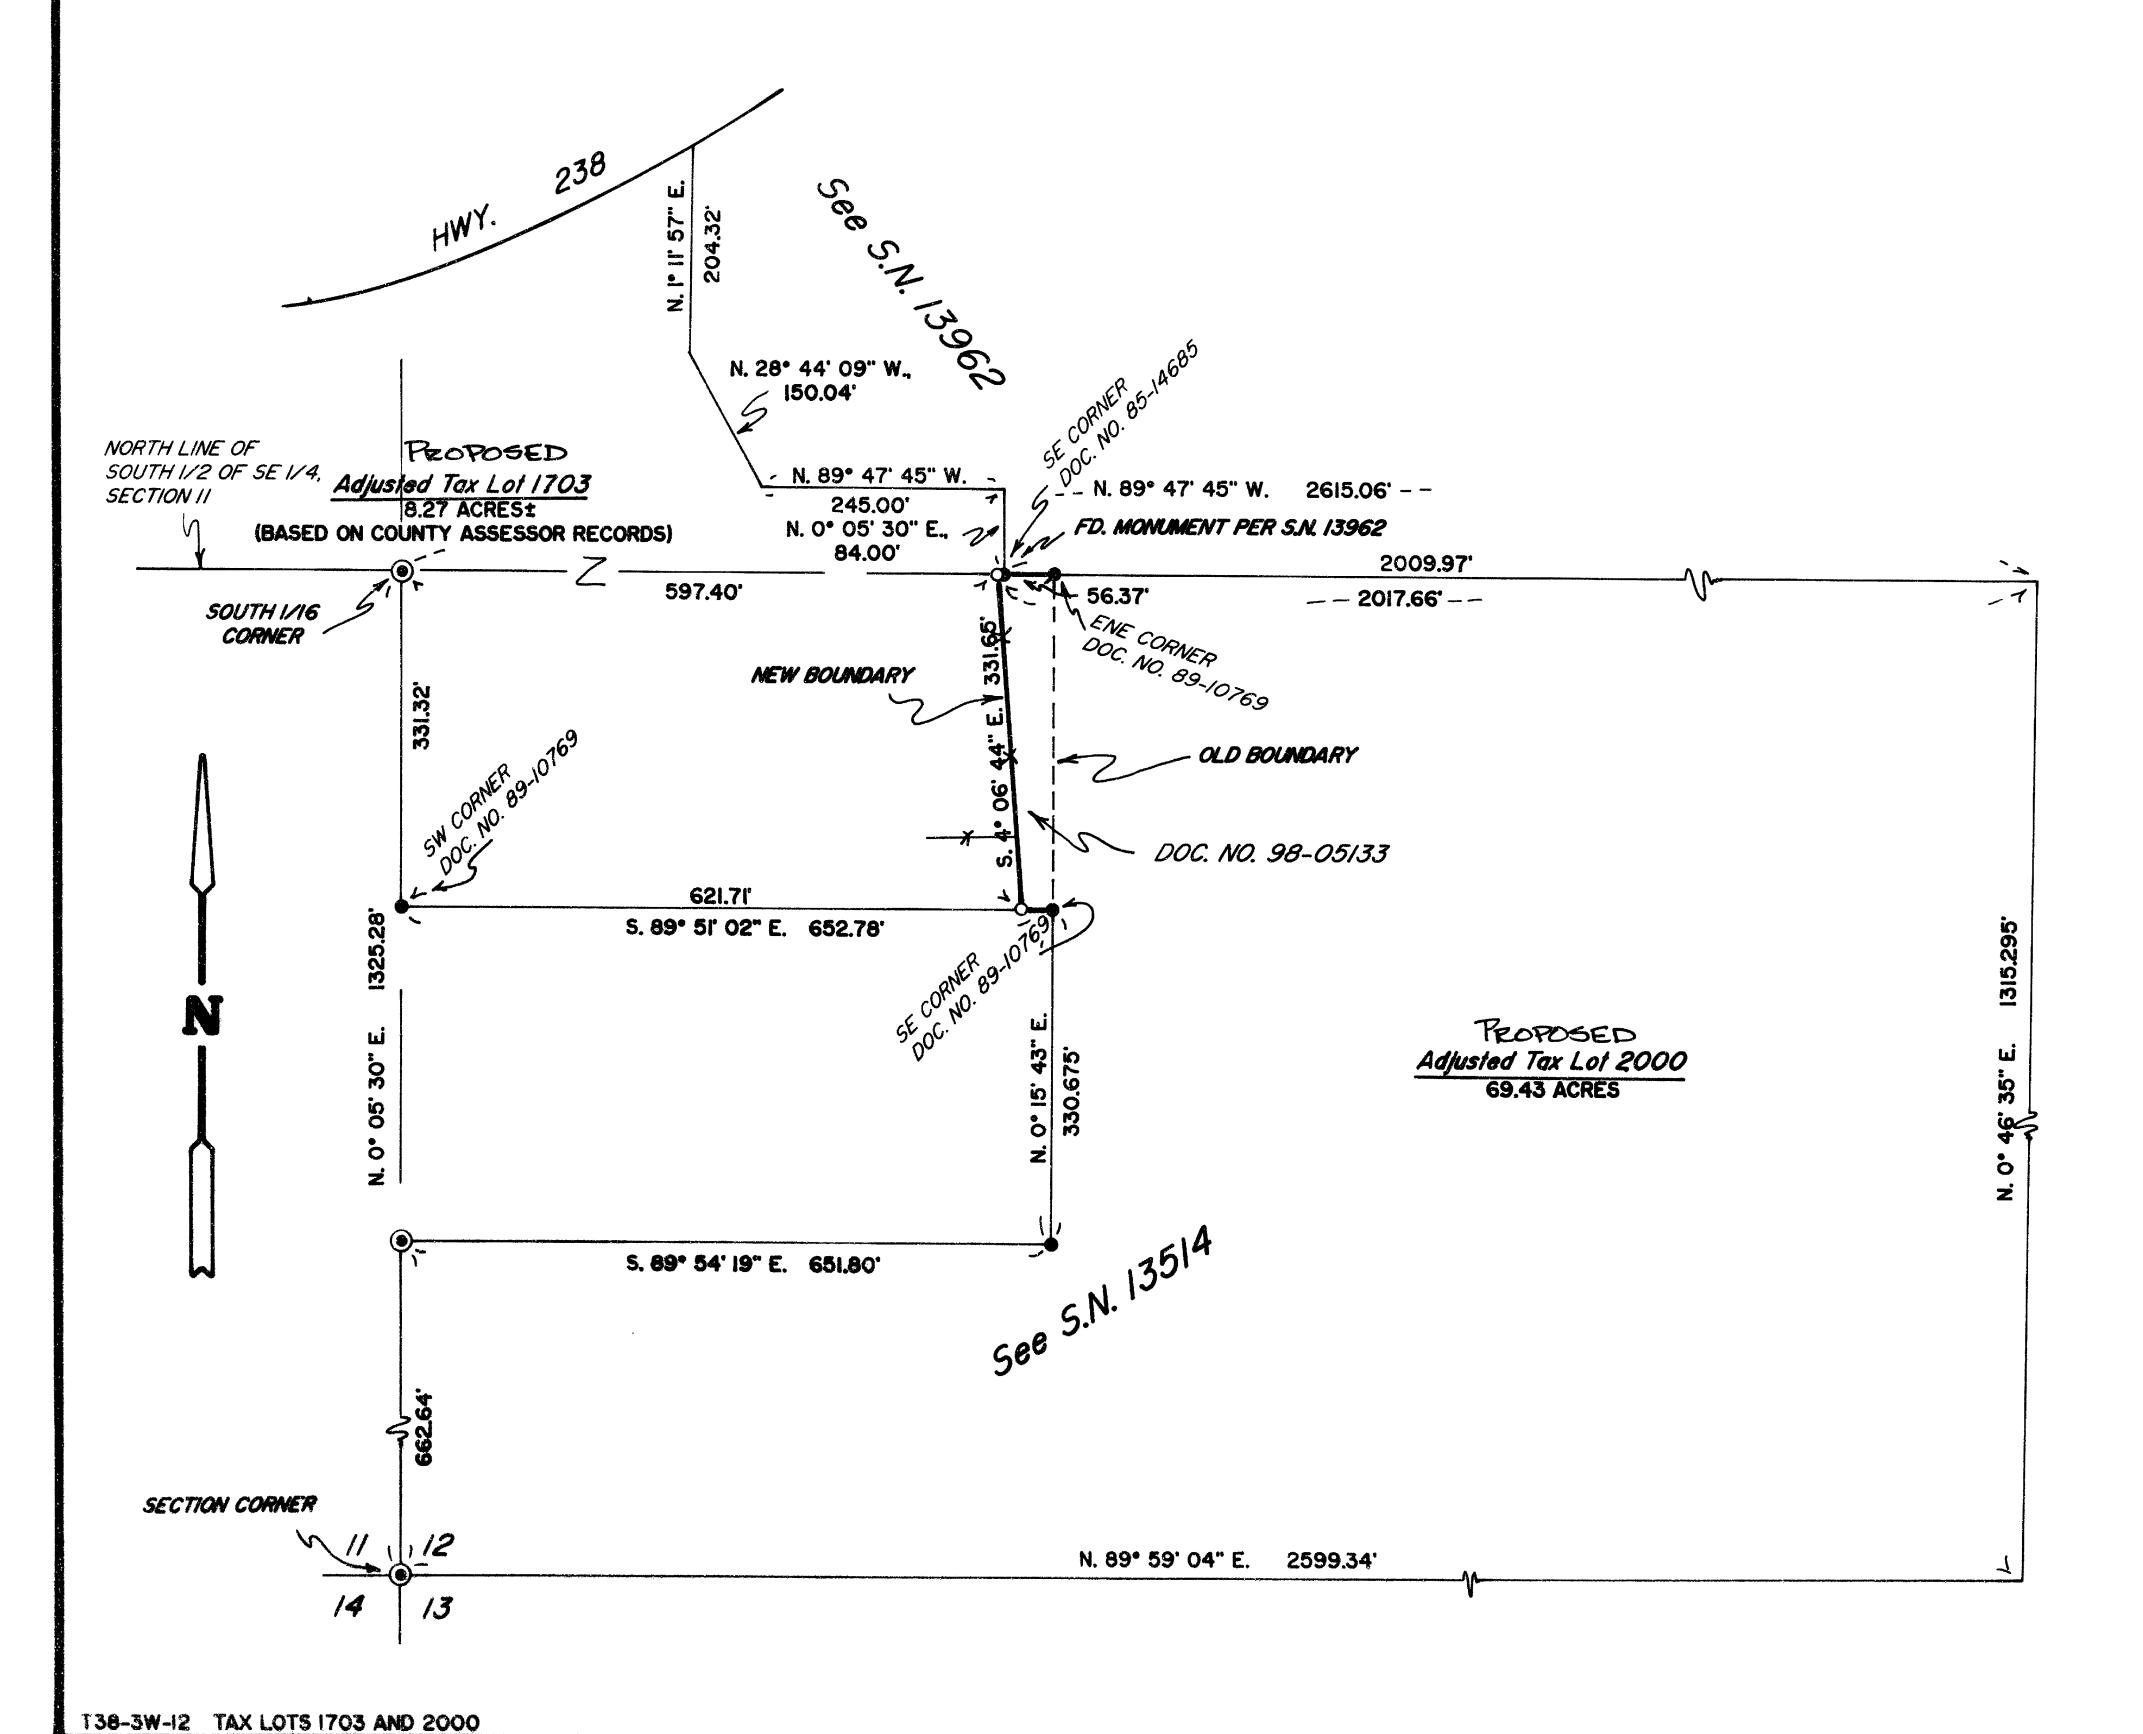

SURVEY NARRATIVE TO COMPLY WITH CHAPTER 209, PARAGRAPH 250, OREGON REVISED STATUTES

<u>PURPOSE</u>

PROPERTY LINE ADJUSTMENT: 97-125-PA; TO LOCATE AND MONUMENT THE ADJUSTED BOUNDARY BETWEEN TAX LOTS 1703 AND 2000 AS SHOWN AND TO PREPARE NEW LEGAL DESCRIPTIONS FOR SAID ADJUSTED TRACTS.

PROCEDURE

UTILIZING EXISTING CONTROL PER S.N. 13514 AND 13962 FILED BY THIS OFFICE, THE NEW BOUNDARY WAS MONUMENTED. NEW LEGAL DESCRIPTIONS WERE THEN WRITTEN USING DEED REFERENCES AS IDENTIFIED.

EQUIPMENT

NIKON DTM-A5 ELECTRONIC TOTAL STATION

LEGEND

- INDICATES A 1991 B.L.M. BR. CAP / IRON PIPE FD.
- INDICATES A MONUMENT FD. PER S.N. 13514 UNLESS NOTED OTHERWISE.
- O INDICATES A 5/8" X 30" STEEL PIN W/ RED PLASTIC CAP MKD. 'R. BRAUGHTON-LS 2657' SET.

B.L.M. = BUREAU OF LAND MANAGEMENT — X FENCE LINE

SCALE: I" = 150' S.N. = SURVEY NUMBER

BASIS OF BEARINGS: EXISTING CONTROL PER S.N. 13514 FILED BY THIS OFFICE.

APPROVAL -97-125-PA

APPROVED BY THE JACKSON COUNTY DEPARTMENT OF PLANNING AND DEVELOPMENT.

BY Katt Jackson DATE 2-25-98