

SURVEY NO. 15690

**SURVEY NARRATIVE TO COMPLY WITH PARAGRAPH 209.250
OREGON REVISED STATUTES**

Survey for: Oregon Opportunities Real Estate
924 E. Jackson St.
Medford, OR. 97504



Location: The Southeast One-Quarter (1/4) of Section 24,
Township 38 South, Range 1 West, Willamette Meridi-
an, Jackson County, Oregon

Purpose: To survey and monument that tract of land described
in Instrument No. 96-06003, Official Records of
Jackson County, Oregon


Procedure: Utilizing a 6-second theodolite with electronic
distance measuring equipment, a control traverse
was run tying monuments as shown on the attached
map. The southern and a portion of the eastern
property lines have been previously surveyed per
Survey Numbers 3704 and 4673. Monuments found were
in close agreement with deed record. The location
of missing corners was computed and monuments were
set as shown.

Basis of
Bearing: Survey No. 3704

Date: February 13, 1998

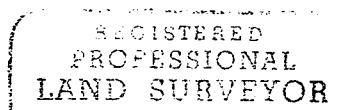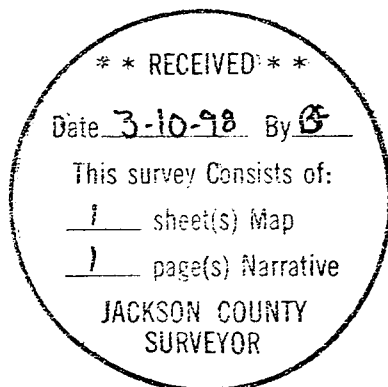

Darrell L. Huck

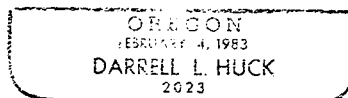

Darrell L. Huck
L.S. 2023 - Oregon
Expires 6/30/99
Hoffbuhr & Associates, Inc.
1062 East Jackson Street
Medford, Oregon 97504

(oroppnrr.dlh)