

15830

Block 5 BARNUM SUBD.

1/4 5/8" Iron Pin
Set 95-00305. ORUCO.
PUE Per


I HEREBY CERTIFY THAT THIS IS AN EXACT COPY
OF THE ORIGINAL PLAT.


SURVEYOR

OREGON
JULY 17, 1986
JAMES E. HIBBS
2234
Renewal Date 6-30-85

AREA LOT 19 - 86599 s.c

Jackson County, Oregon
Recorded
OFFICIAL RECORDS
JUL 17 1998
8:17 AM
Arthur J. Beckwith
COUNTY CLERK

 = MEMENTOS DIFFERING FROM
OFFICIAL PLAT.

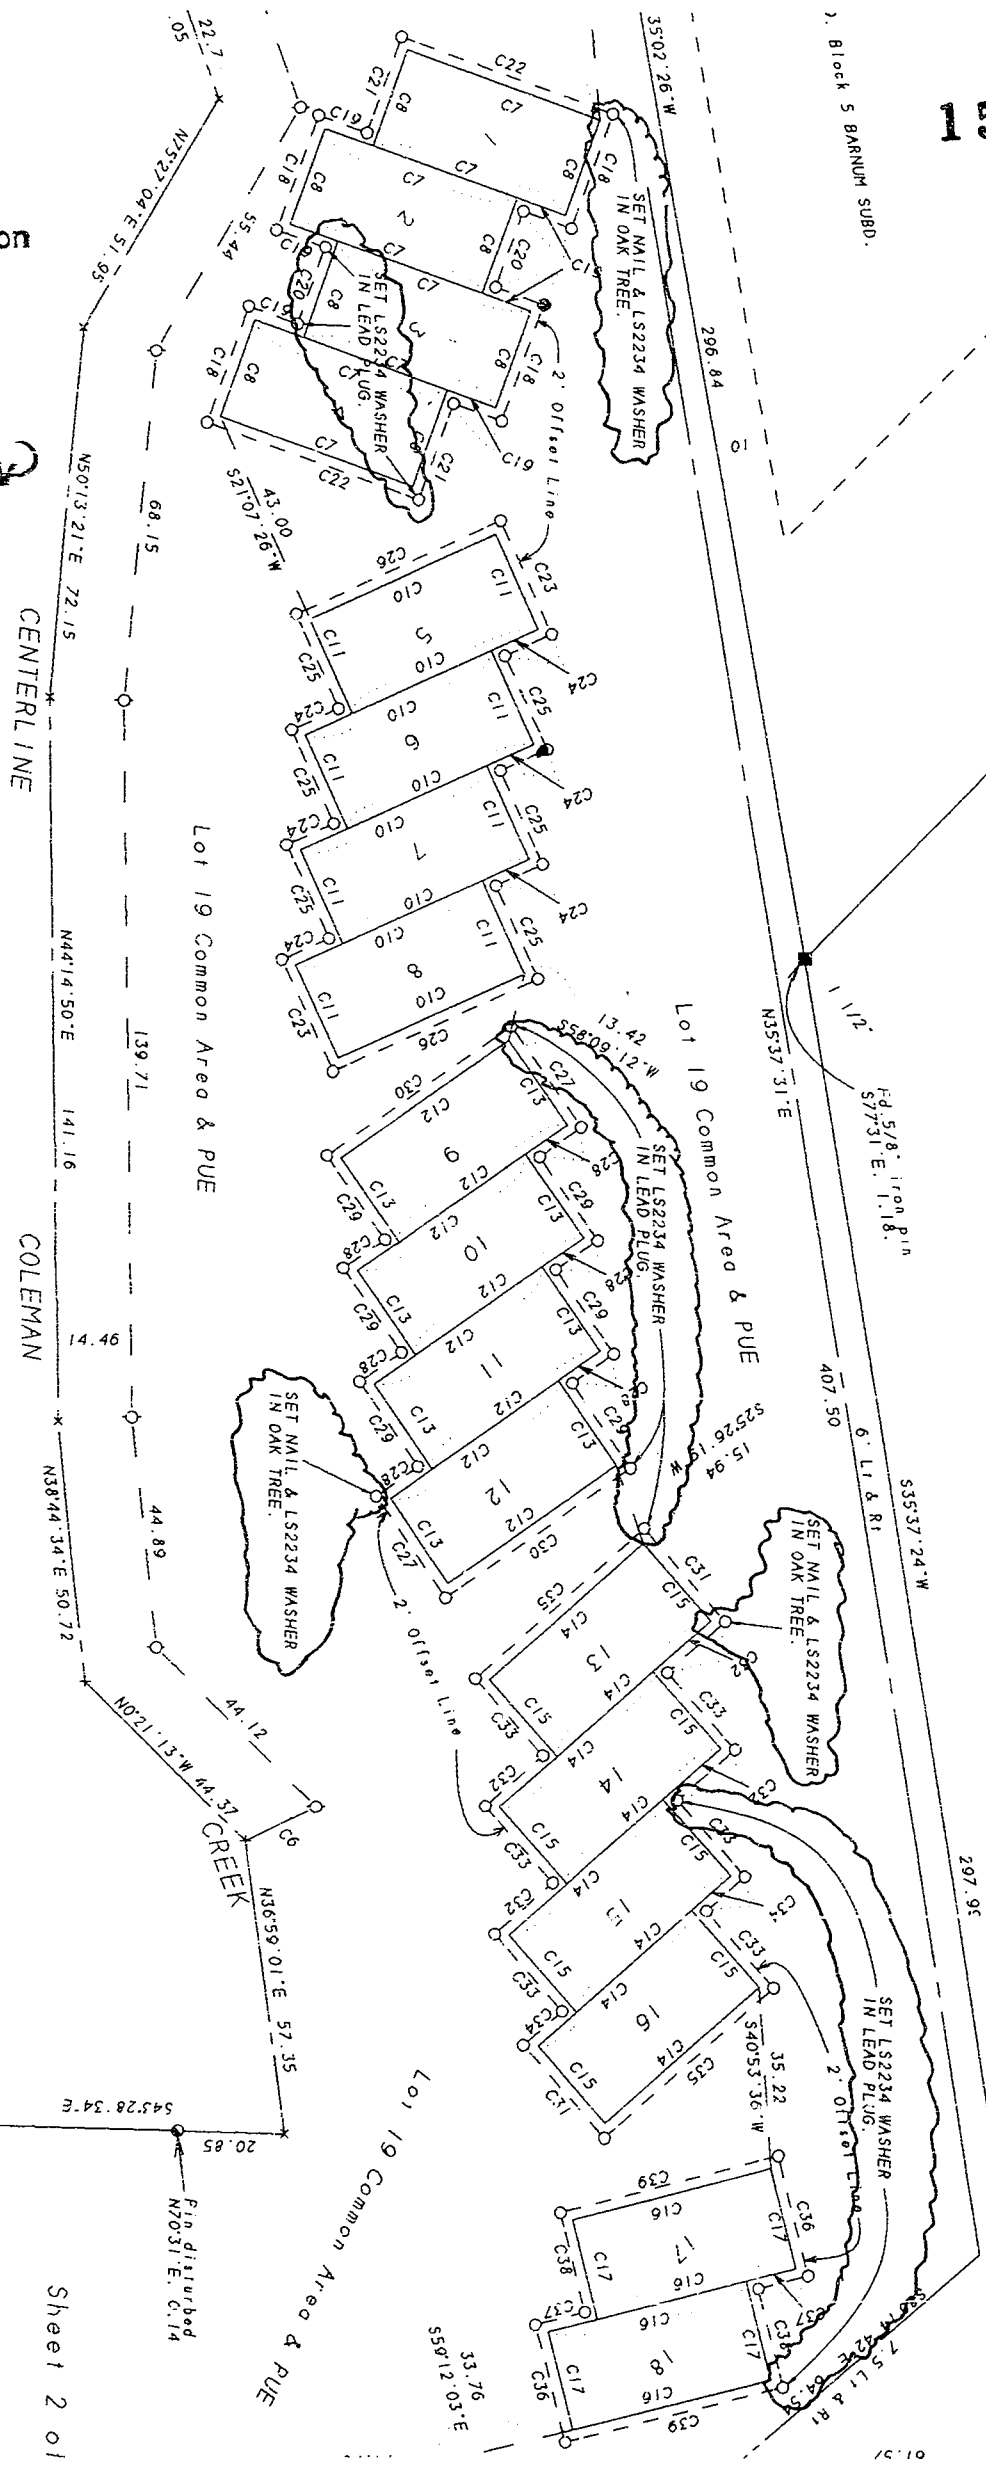

Rotation: 45°
4725:000 N 486C

Sheet 2 of 1

EXHIBIT A

2

