
36-2W-1 Tax Lot 1003

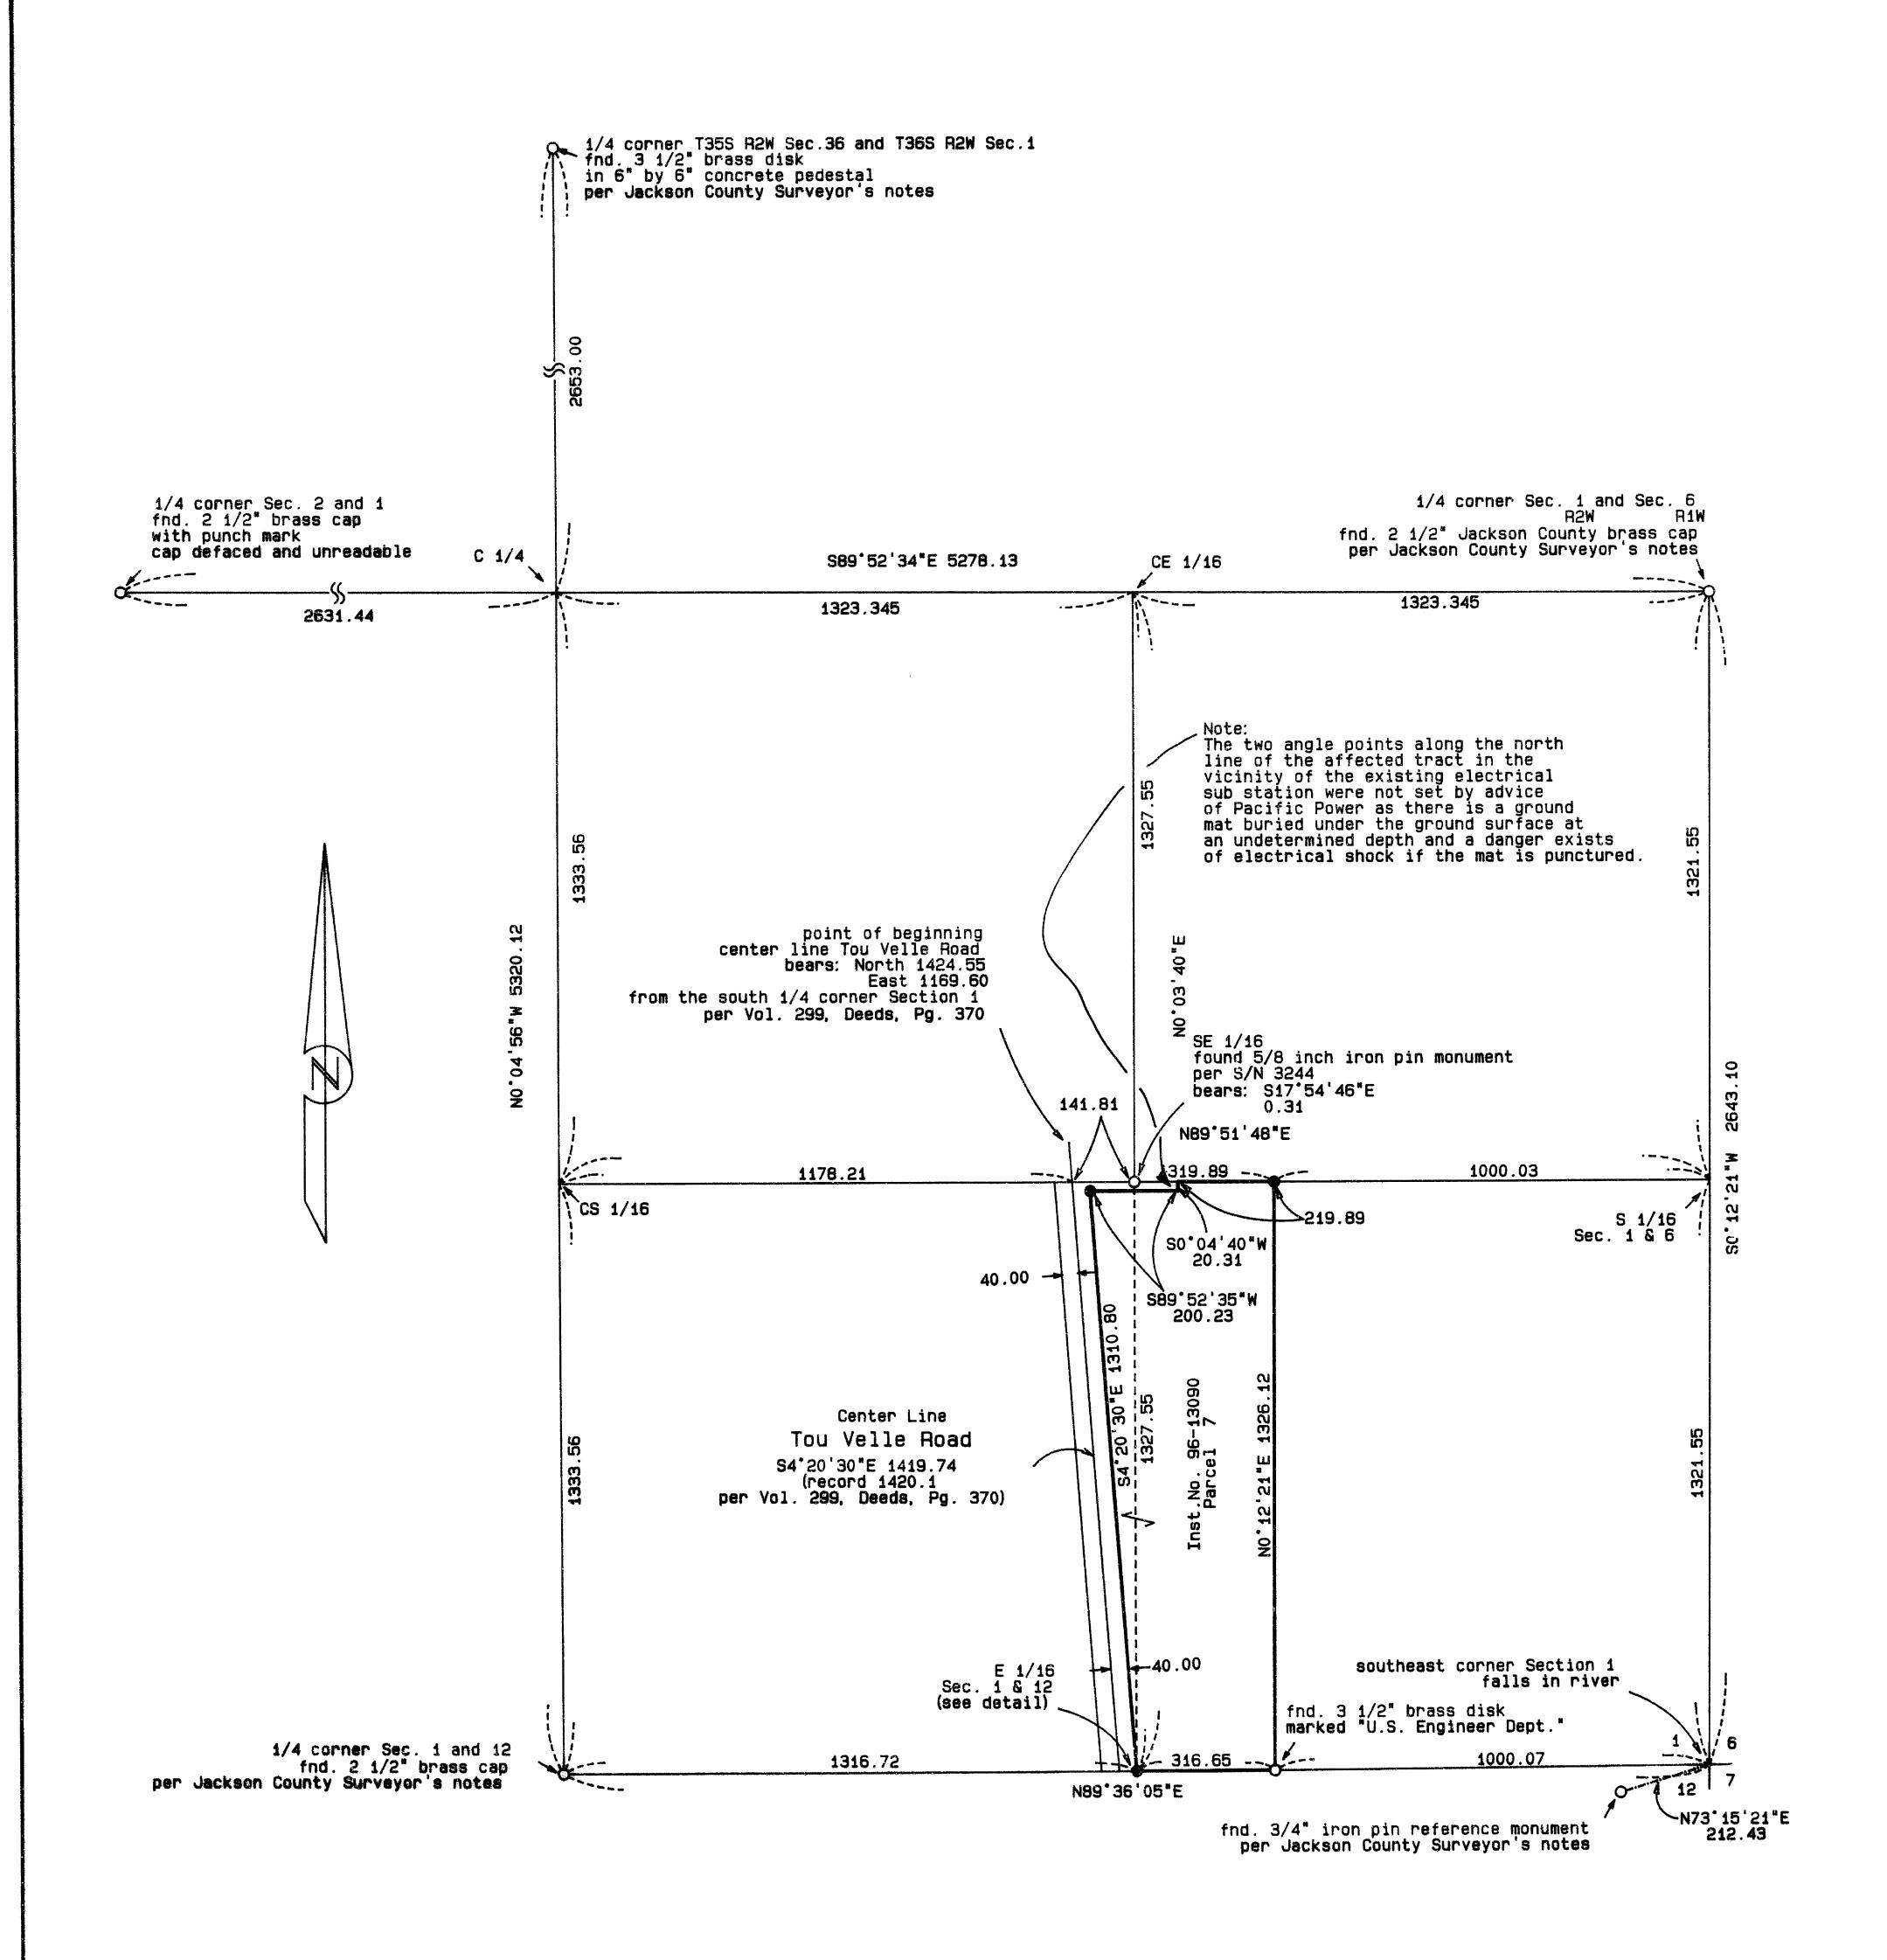

## Map of Survey

Located in all quarters of Section 1, Township 36 South, Range 2 West of the Willamette Meridian, Jackson County, Oregon.

for

## RRIP, Ltd.

10772 Modoc Road White City, Oregon 97503

## Legend:

Basis of bearing is NAD-83 True north as derived by global positioning satellite observations.

Vol., Pg. are Volume and Page of the Record of Jackson County, Oregon as indicated.

Inst. No. is Instrument Number of the Official Records of Jackson County, Oregon.

O found monument as indicated.

• set 5/8 by 24 inch iron pin monument with yellow plastic cap marked "FARBER PLS 2189".


## SURVEY NARRATIVE TO COMPLY WITH O.R.S. 209.250

Purpose:

To survey and monument that tract described in Instrument No. 96-13090, Parcel 7 of the Official Records of Jackson County, Oregon.

Procedure:

Utilizing global positioning satellite receivers and a Nikon total station and Sokkia SDR-33 data collector I tie the monuments as show. The tract as described in Inst. No. 96-13090 was located and monumented as shown.

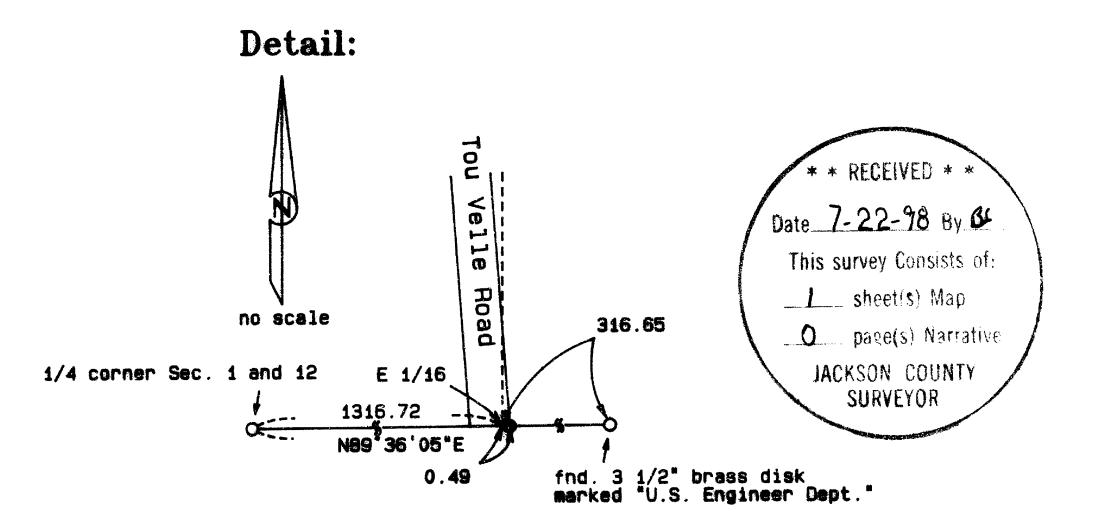



RENEWAL DATE 12-31-99

FARBER & SONS, INC.

dba FARBER SURVEYING

(541) 776-0846

DEFICE LOCATION: MAILT

OFFICE LOCATION: 120 MISTLETOE MEDFORD, OREGON 97501 MAILING ADDRESS: P. O. BOX 5286 CENTRAL POINT, OREGON 97502

COMPUTED BY: haf SCALE = 1 inch: 300 feet DATE: 23 JUL 1998 HOTATION: 0° JOB No. 0691-97

ORIGIN: 198000.000 N 296400.000 E

SURVEYED BY: