


# MAP OF SURVEY

Located in the Southwest 1/4 of Section 32.  
T.37 S., R.4 W., W.M. Jackson County, Oregon

DOC. #75-09408. ORJCO.

DOC. #84-03537. ORJCO.

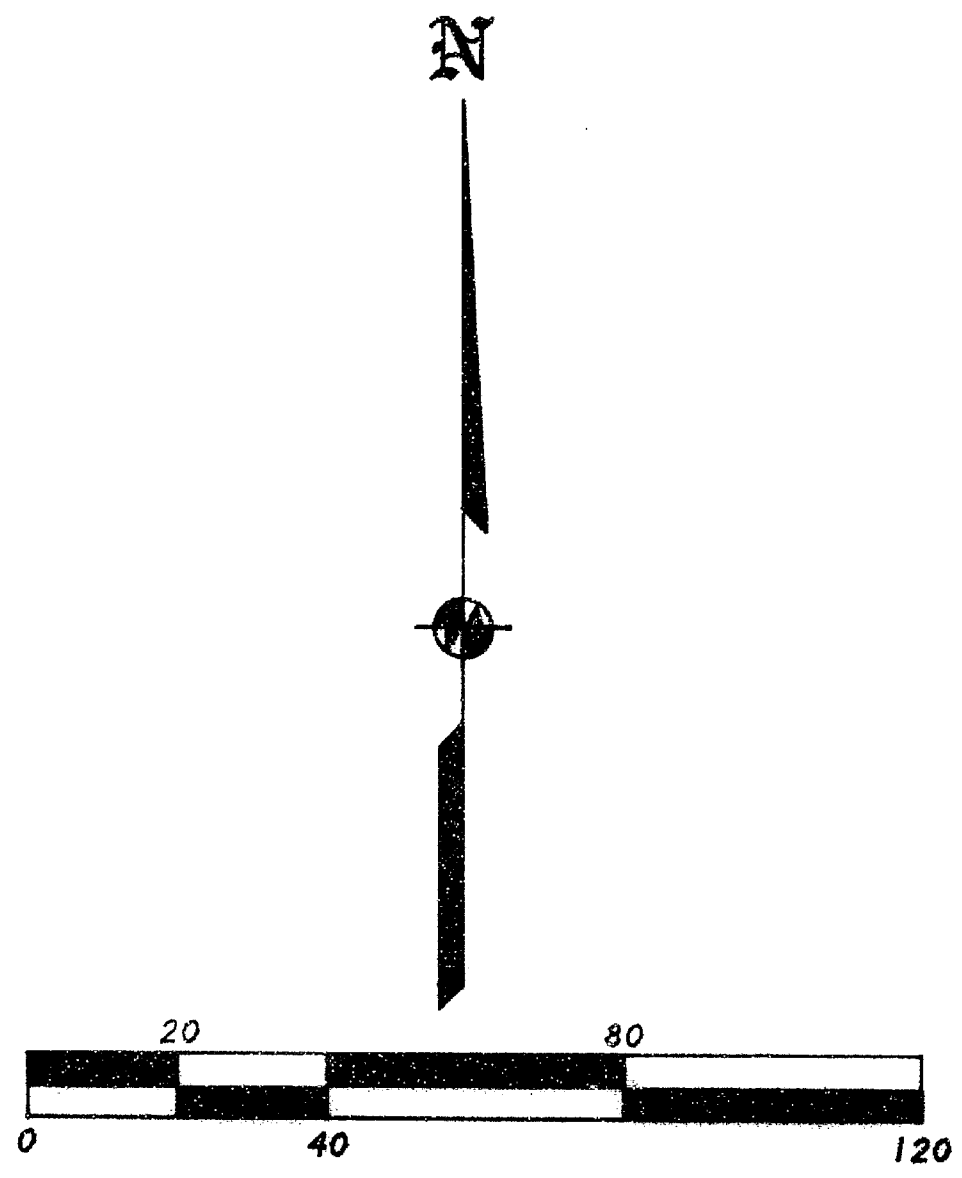

S0°03'26"E

25

227.04

209.06

N-S CENTERLINE SECTION 32 PER RS9859

2009.74 (DR 2010)

97.48

115.47

30.67

25

1685.22 (1685.45)











**\*\* RECEIVED \*\***  
Date 9-30-98 By [Signature]  
This survey consists of:  
1 sheet(s) Map  
0 page(s) Narrative  
JACKSON COUNTY SURVEYOR

**SURVEY FOR:**  
THEODORE D. WARRICK  
818 SLAGLE CREEK ROAD  
GRANTS PASS, OR 97526

**SURVEY BY:**  
L.J. FRIAR & ASSOCIATES, P.C.  
CONSULTING LAND SURVEYORS  
816 WEST EIGHTH STREET  
MEDFORD, OREGON 97501  
PHONE: (541) 772-2782

**LEGEND:**  
● - FD. 5/8" IRON PIN W/ PLASTIC CAP MKD. THOMPSON PLS1358 PER RS9859.  
○ - SET 5/8" X 24" IRON PIN W/ PLASTIC CAP MKD. FRIAR PLS961.  
( ) - RECORD DATA AS SHOWN.  
RS - RECORDED SURVEY \*  
ORJCO - OFFICIAL RECORDS OF JACKSON COUNTY, OREGON.

**BASIS OF BEARINGS:** SURVEY NO. 9859 AS SHOWN.  
**DATE:** DECEMBER 11, 1988 **UNIT OF MEASUREMENT:** FEET **SCALE:** 1" = 40'

**SURVEY NARRATIVE TO COMPLY WITH O.R.S. 209.250**  
**PURPOSE:** TO SURVEY AND MONUMENT THE ADJUSTED PROPERTY LINES AS REQUESTED BY THE CLIENT EXCHANGING EQUAL AREAS IN TL'S 600, 802 & 1600.  
**PROCEDURE:** LOCATED AND USED FOR CONTROL THE INDICATED PINS FROM RS9859. THEN SURVEYED AND MONUMENTED THE NEW BOUNDARY LINE AS SHOWN HEREON. THOSE MONUMENTS FOUND AS WELL AS THOSE SET ARE AS SHOWN HEREON.  
**NOTE:** DUE TO AN OVERSIGHT THIS SURVEY WAS NOT RECORDED IN 1988. IT IS BEING RECORDED AT THIS TIME TO MAKE THE SURVEY AND MONUMENTS PUBLIC RECORD.

REGISTERED PROFESSIONAL LAND SURVEYOR  
*[Signature]*  
OREGON  
JULY 18, 1971  
LARRY J. FRIAR  
961  
Renewal Date 12-31-99

1/4 COR SECS.  
32 & S. FD.  
5/8" IRON PIN.

374W32 TL'S 600, 802 & 1600