



SURVEY No. **15917**

SURVEY NARRATIVE TO COMPLY WITH PARAGRAPH 209.25 ORS

SURVEY FOR: JIMMIE LaBRENSZ  
6424 FROST LN  
TALENT, OR. 97540



LOCATION: E1/2 SECTION 26,  
TOWNSHIP 38 SOUTH, RANGE 1 WEST,  
WILLAMETTE MERIDIAN, JACKSON CO. OREGON

PROCEDURE: UTILIZING FOUND MONUMENTS FOR MY  
CONTROL, I SET THE PROPERTY CORNERS AS  
SHOWN ON THE MAP OF SURVEY. FOR THE  
WESTERLY BOUNDARY, I HELD RECORD ANGLE  
ALONG THE TID CANAL AND THE SOUTHERLY  
BOUNDARY LINE. THE EASTERLY BOUNDARY  
WAS SET ALONG FROST LANE RIGHT OF WAY.

DATE: OCTOBER 1, 1998

SURVEYED BY: LLOYD R SMITH PLS  
7050 HWY 140  
EAGLE POINT, OREGON 97524

BASIS OF BEARING : SOUTHERLY RIGHT OF WAY WAGNER CREEK ROAD

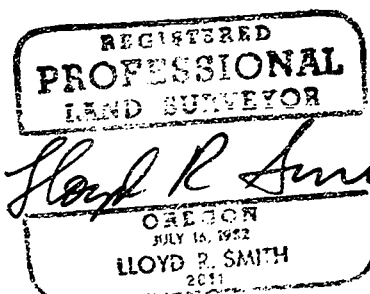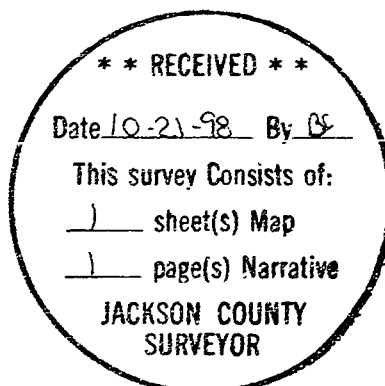

*Exp 6-30-00*