PROPERTY LINE ADJUSTMENT

JACKSON COUNTY PLANNING ACTION 98-335-PA
LOCATED IN
NORTH 1/2 SEC. 17, T36S, R1W, W.M.
JACKSON COUNTY, OREGON

OCTOBER 16, 1998

SURVEY FOR :
EUGENE F. BURRILL LUMBER CO.
300 CRATER LAKE AVE. SUITE 2A
MEDFORD, OR 97504
(541) 776-1311

NARRATIVE

PURPOSE: TO SURVEY AND MAP THE PROPERTY LINE ADJUSTMENT (98-335-PA) AS APPROVED BY THE JACKSON COUNTY DEPARTMENT OF PLANNING AND DEVELOPMENT.

PROCEDURE: FILED SURVEY NO.'S 9396, 12975, AND 15562, ALONG WITH APPROPRIATE DEEDS WERE USED TO DETERMINE THE BOUNDARY OF THE SUBJECT PROPERTY TO BE ADJUSTED. THE ADJUSTED PROPERTY LINES WERE DETERMINED PER CLIENT'S REQUEST.

BASIS OF BEARING: SURVEY NO. 9396 – PORTION OF NORTH LINE OF SECTION 17 AS SHOWN

REGISTERED PROFESSIONAL LAND SURVEYOR
Richard L. Bath
OREGON
JULY 30, 1976
RICHARD L. BATH
No. 1069
EXP. 12/31/99

N

SCALE: 1"=400'

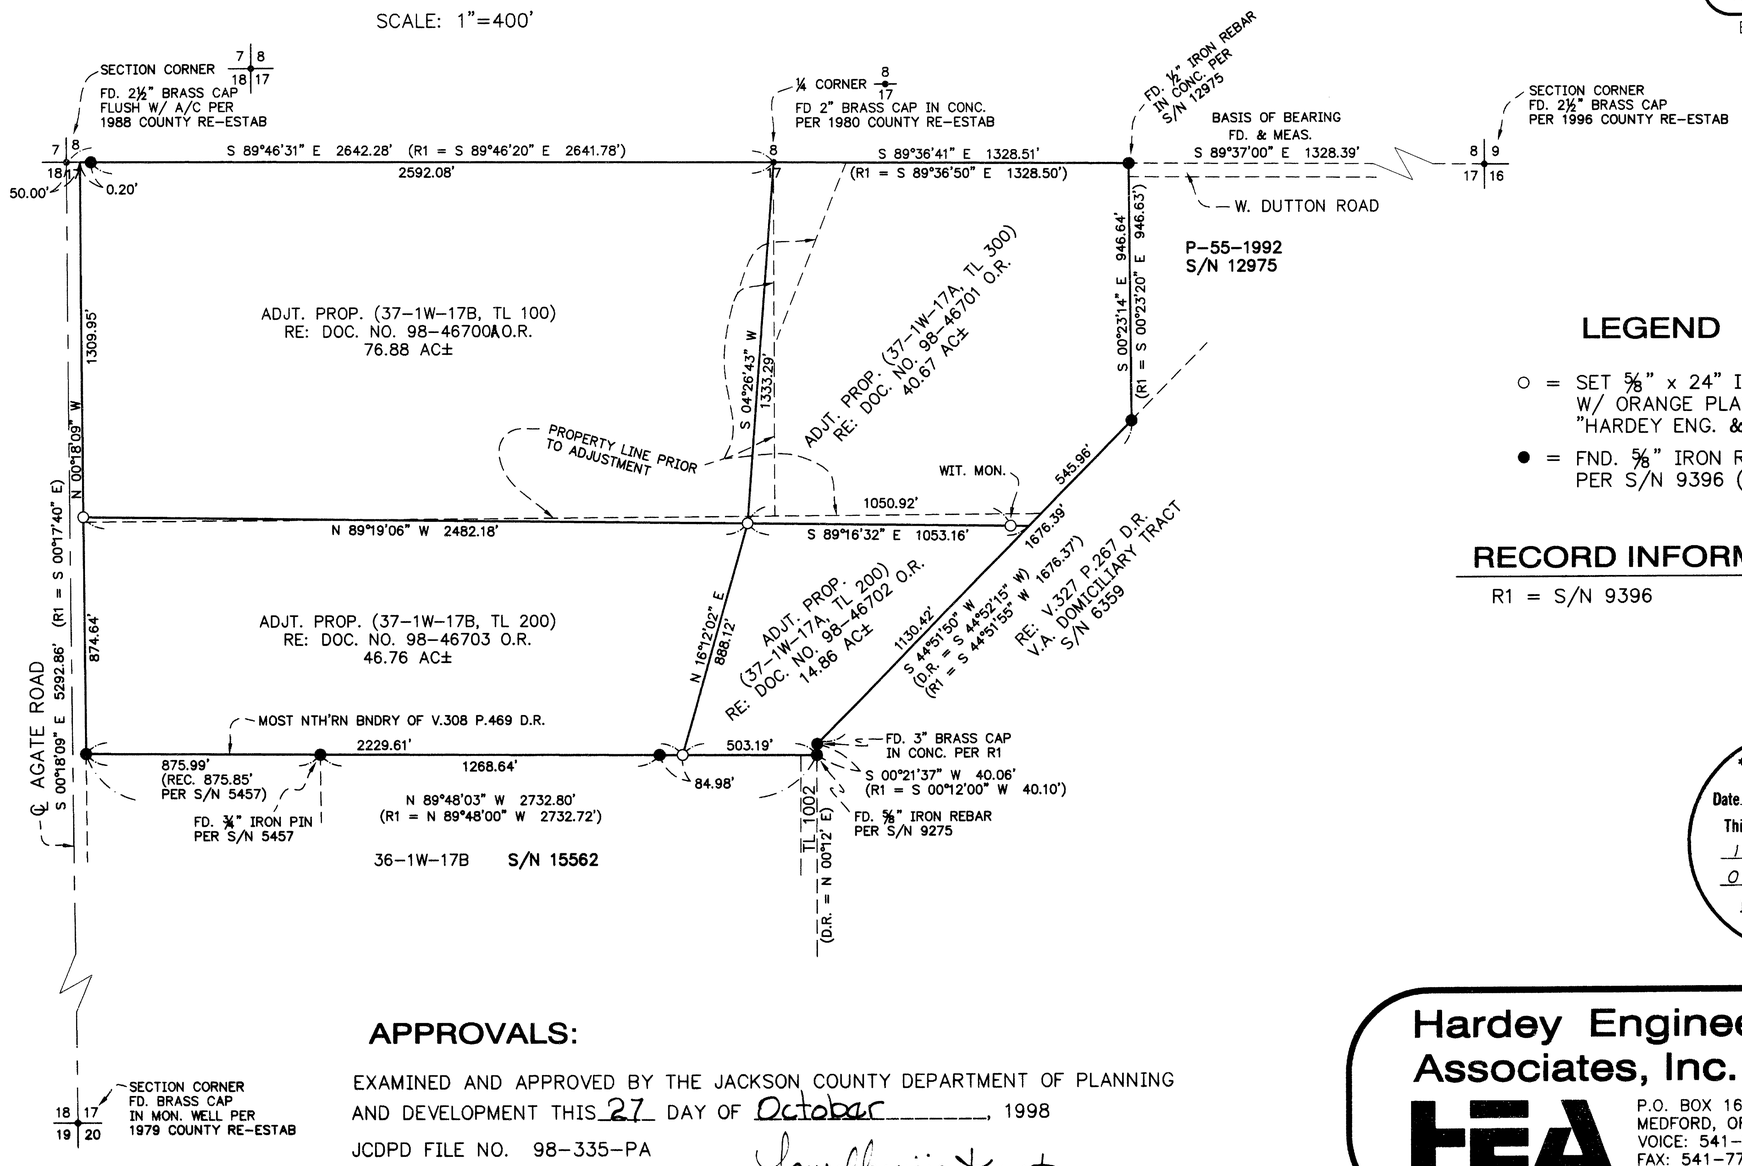

LEGEND

○ = SET ⅝" x 24" IRON REBAR W/ ORANGE PLASTIC CAP MARKED "HARDEY ENG. & ASSOC."

● = FND. ⅝" IRON REBAR PER S/N 9396 (R1)

RECORD INFORMATION

R1 = S/N 9396

** RECEIVED **
Date 10-27-98 By CF
This survey Consists of:
1 sheet(s) Map
0 page(s) Narrative
JACKSON COUNTY SURVEYOR

APPROVALS:

EXAMINED AND APPROVED BY THE JACKSON COUNTY DEPARTMENT OF PLANNING AND DEVELOPMENT THIS 27 DAY OF October, 1998

JCDPD FILE NO. 98-335-PA

Laurel Prairie Kuntz
COUNTY PLANNER

Hardey Engineering & Associates, Inc.
HEA ENGINEERING INTEGRITY
P.O. BOX 1625
MEDFORD, OREGON 97501-0124
VOICE: 541-772-6880
FAX: 541-772-9573
EMAIL: hardey@wave.net

BURRPLA/PRO-ADJ2.DWG
PROJECT NO. 097-29-98

36 1W 17A TL's 200, & 300
36 1W 17B TL's 100, & 200