

SURVEY NO. 16010

**SURVEY NARRATIVE TO COMPLY WITH PARAGRAPH 209.250
OREGON REVISED STATUTES**

SURVEY FOR: Robert S. MacLellan
185 Black Oak Drive
Medford, Oregon 97504

LOCATION: SE 1/4 of Section 9, Township 38 South, Range 1 West,
Willamette Meridian, Jackson County, Oregon.



PURPOSE: To monument the new right-of-way line for Bolz Road and replace
monuments from previous surveys.

PROCEDURE: Located monuments from Filed Survey Nos. 7882, 15079, and
13510 and tied by traverse. The new Southeasterly right-of-way
line for Bolz Road was monumented as described in Instrument
No. 98-44271, Official Records. The vacated street at the North-
east corner of the survey was monumented as described in City
of Phoenix Ordinance No. 450 and at the centerline of Church
Street as shown on the Plat of the Town of Phoenix, dated May,
1872.

BASIS OF BEARINGS: The Southeasterly line of Bolz Road as shown on the Plat of
Gemini Estates Subdivision (Filed Survey No. 7882).

DATE: December 15, 1998

MARQUESS & ASSOCIATES, INC.
1120 East Jackson Street
P. O. Box 490
Medford, OR 97501

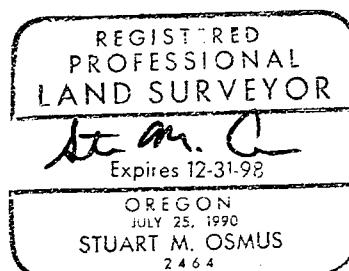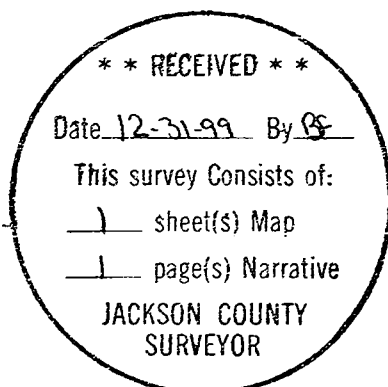

Stuart M. Osmus, PLS