

SURVEY NO. 16049

**SURVEY NARRATIVE TO COMPLY WITH PARAGRAPH 209.250
OREGON REVISED STATUTES**

Survey For: Wm. Story, Jr. & J.A. Story
12051 Hwy. 140
Eagle Point, OR. 97524


Location: Southwest One-Quarter (1/4) of Section 12 and the Northwest One-Quarter (1/4) of Section 13, Township 36 South, Range 1 East, Willamette Meridian, Jackson County, Oregon

Purpose: To adjust property lines as shown on the attached map.

Procedure: Utilizing a one-second total station, I located monuments shown. I then monumented the adjusted property lines per Instruments 99-02416, 99-02417 and 99-02418 of the Official Records of Jackson County, Oregon.

Basis of Bearing: Filed Survey No. 6249

Date: July 15, 1998

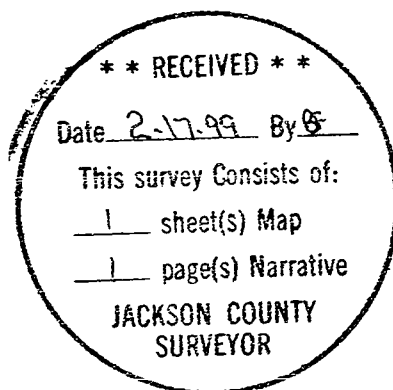

REGISTERED
PROFESSIONAL
LAND SURVEYOR

Douglas C. McMahan

OREGON
JULY 18, 1980
DOUGLAS C. McMAHAN
No. 1913

Douglas C. McMahan
L.S. 1913 - Oregon
Expires 12/31/00
Hoffbuhr & Associates, Inc.
1062 East Jackson St.
Medford, Oregon 97504

(strywmnr.dcm)