

# MAP OF SURVEY

LOCATED IN THE NE 1/4 OF SECTION 8, T.33S., R.1W., W.M.  
JACKSON COUNTY, OREGON

### SURVEY FOR

STEVEN D. AND VICKI L. LEHMAN  
6220 HWY. 227  
TRAIL, OR 97541

### LEGEND:

- FOUND 5/8" REINFORCING ROD AS SHOWN
- SET 5/8" X 24" IR/CAP LS 2541
- ⊙ WELL
- (R) RECORD
- (RS) RECORD OF SURVEY
- (M) MEASURED
- (C) CALCULATED

### BASIS OF BEARING:

THE BASIS OF BEARING WAS DETERMINED FROM FIELD TIES BETWEEN EXISTING MONUMENTS FOUND ALONG THE RIGHT-OF-WAYS OF HIGHWAY 227 AND SWINGLE ROAD AS SHOWN HEREON AND ALSO SHOWN ON RS 5151.

### NARRATIVE:

PURPOSE: TO LOCATE EXISTING MONUMENTS AND/OR SET MONUMENTS ACCORDING TO DEED #81-07616 ALONG THE SOUTHERLY BOUNDARY OF THE DESCRIBED PARCEL.

PROCEDURE: A CLOSED TRAVERSE WAS PERFORMED ALONG THE SOUTH BOUNDARY OF SAID PARCEL TIEING RIGHT-OF-WAY OF O.S.H.227 AND SWINGLE ROAD THEN CONTINUING TO THE CENTER 1/4 OF SECTION 8.

COMMENTS: MONUMENTS THAT WERE FOUND ALONG THE SOUTH BOUNDARY WERE EITHER IN THE FLOWING CREEK OR IMMEDIATELY ALONG SIDE. THEIR RELATIVE POSITIONS ARE SHOWN HEREON. MONUMENTS WERE SET AT DEED BEARINGS AND DISTANCES AS SHOWN.

### EQUIPMENT:


LIETZ SET4C TOTAL STATION.

### REFERENCE DOCUMENTS:

WARRANTY DEED 81-07616  
RS 4118  
RS 5151

**\*\* RECEIVED \*\***  
Date: 4-15-99 By: [Signature]  
This survey consists of:  
1 sheet(s) Map  
0 page(s) Narrative  
JACKSON COUNTY SURVEYOR

REGISTERED PROFESSIONAL LAND SURVEYOR  
[Signature]  
OREGON JAN 21 1998  
DANIEL L. SEBERT  
EXPIRES 6-30-00

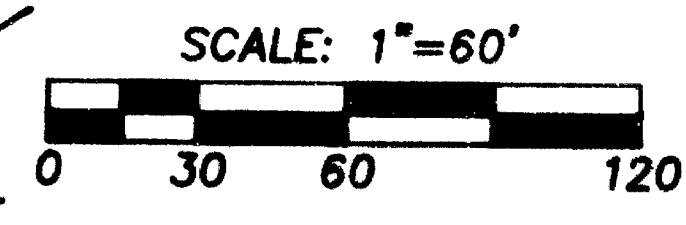

April 1999  
Scale 1"= 60'

**L&S SURVEYING**  
78 Leafwood Dr.  
Eagle Point, OR 97524

