

1" = 100'

**SURVEY NARRATIVE**

**PURPOSE:** To survey the Deed corners of my clients property and to mark said corners as shown on accompanying map. The North Deed line was brushed and marked with 60d spikes and 2" wood stakes, set on true line at certain intervals.

**PROCEDURE:** From existing control set on filed survey 12336 and 15949. I tied the Northeast and Southeast corners of Lot 18, "Pleasant Valley Farm Tracts". I then computed the Deed corners of O.R. 92-04623 and set as shown.

**LEGEND**



- SET 5/8"X30" REBAR WITH YELLOW PLASTIC CAP MARKED "TEMPLIN LS 2359"
- FOUND 5/8" IRON ROD PER FILED SURVEY NUMBER 4398
- FOUND 1/2" IRON PIPE PER "PLEASANT VALLEY FARM TRACTS"
- [ ] RECORD BEARING/DISTANCE PER FILED SURVEY NUMBER 4398
- ( ) RECORD BEARING/DISTANCE PER "PLEASANT VALLEY FARM TRACTS"
- (( )) DEED RECORD

BEARINGS BASED UPON CONTROL SET ON FILED SURVEY NUMBER 12336.

F.S. 12336

F.S. # 15949

F.S. # 4398

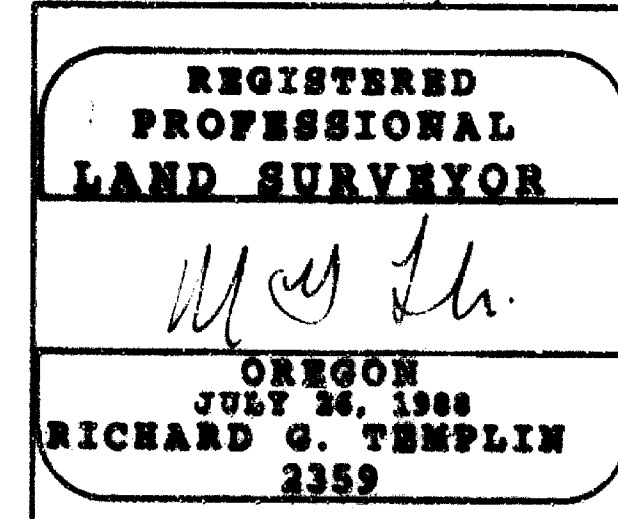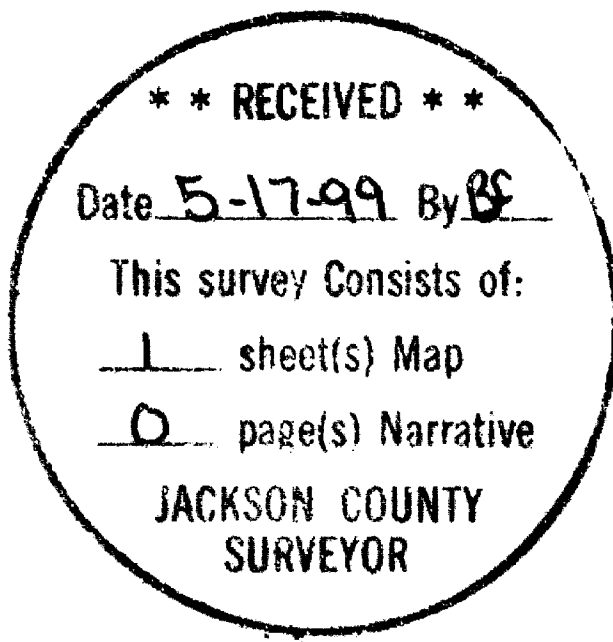

<b>REGISTERED PROFESSIONAL LAND SURVEYOR</b> RICHARD G. TEMPLIN 2359		<b>RICHARD TEMPLIN LAND SURVEYING</b> 100 POORMAN CR. RD. 899-2032 JACKSONVILLE, OREGON 97530	
MAP OF SURVEY LOCATED IN THE SW 1/4 OF SECTION 22, T.35 S., R.4 W., W.M. JACKSON COUNTY, OREGON		SURVEYED FOR: Mr. Larry Whitney 6214 East Evens Cr. Rd. Rogue River, Or. 97537	
OREGON JULY 26, 1988 RICHARD G. TEMPLIN 2359		DATE: May 12, 1999	
RENEWAL DATE: JUNE 30, 00			

35\_4W\_22\_tl 1205