


16204

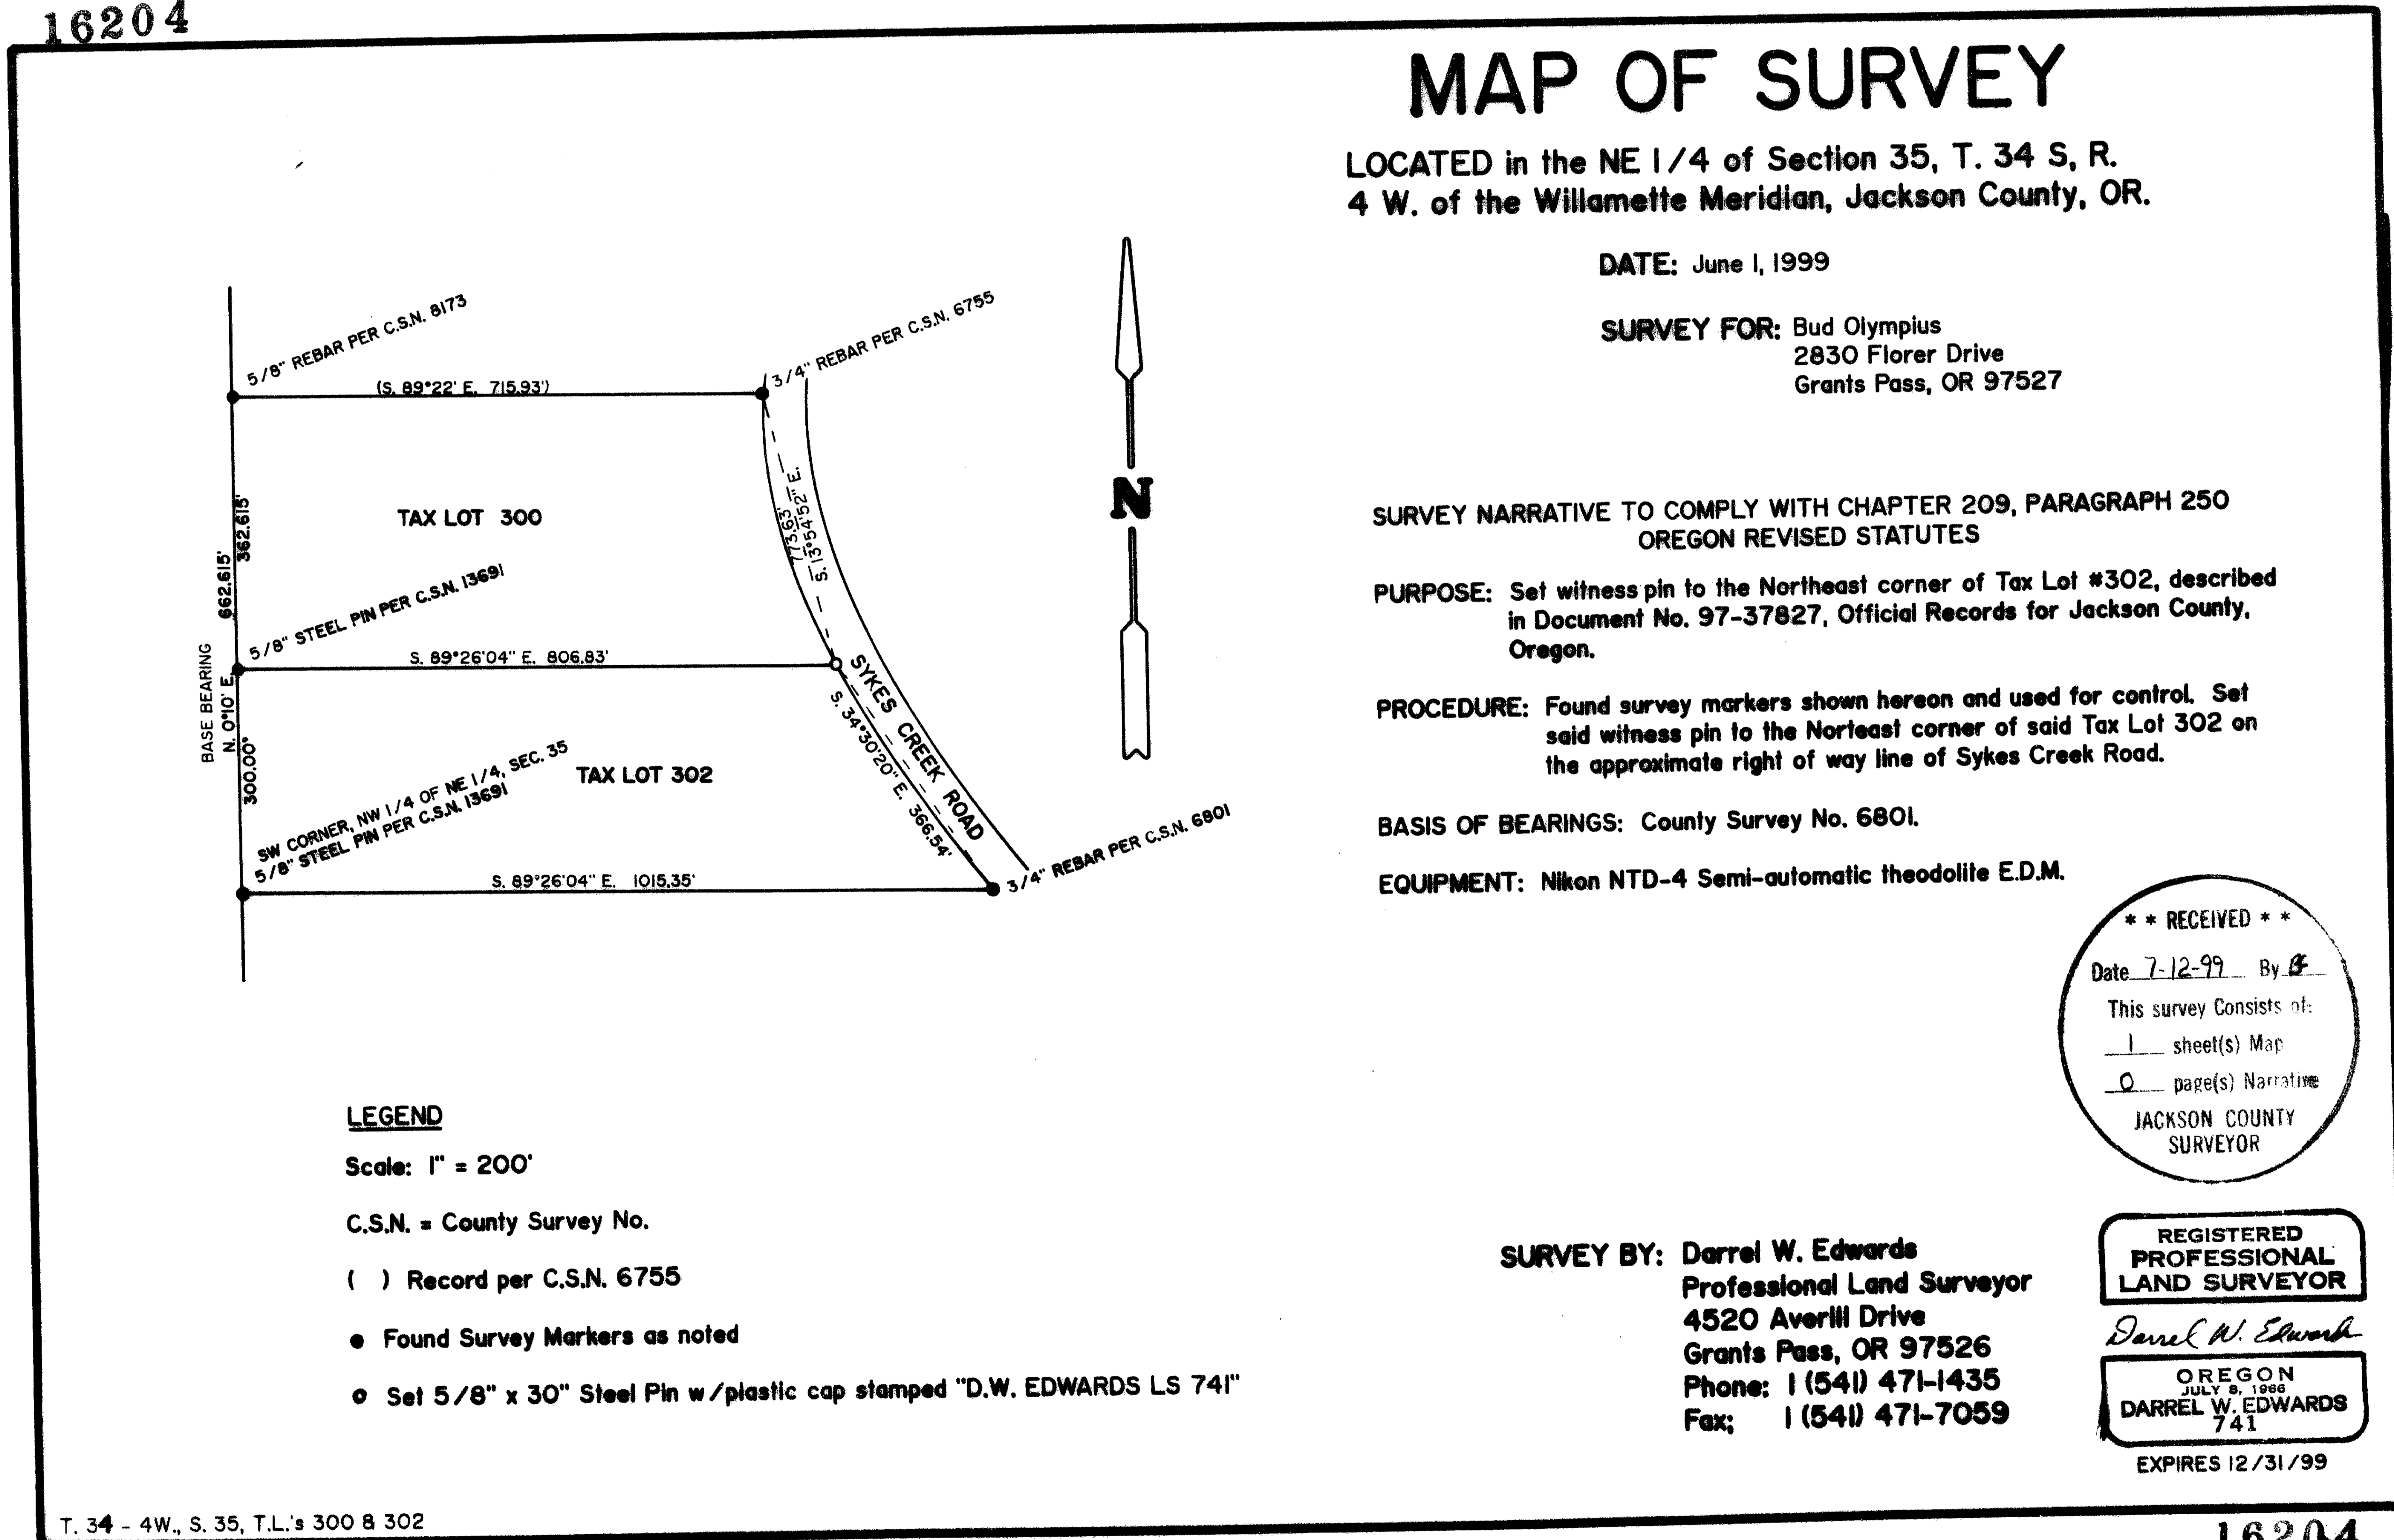

16204