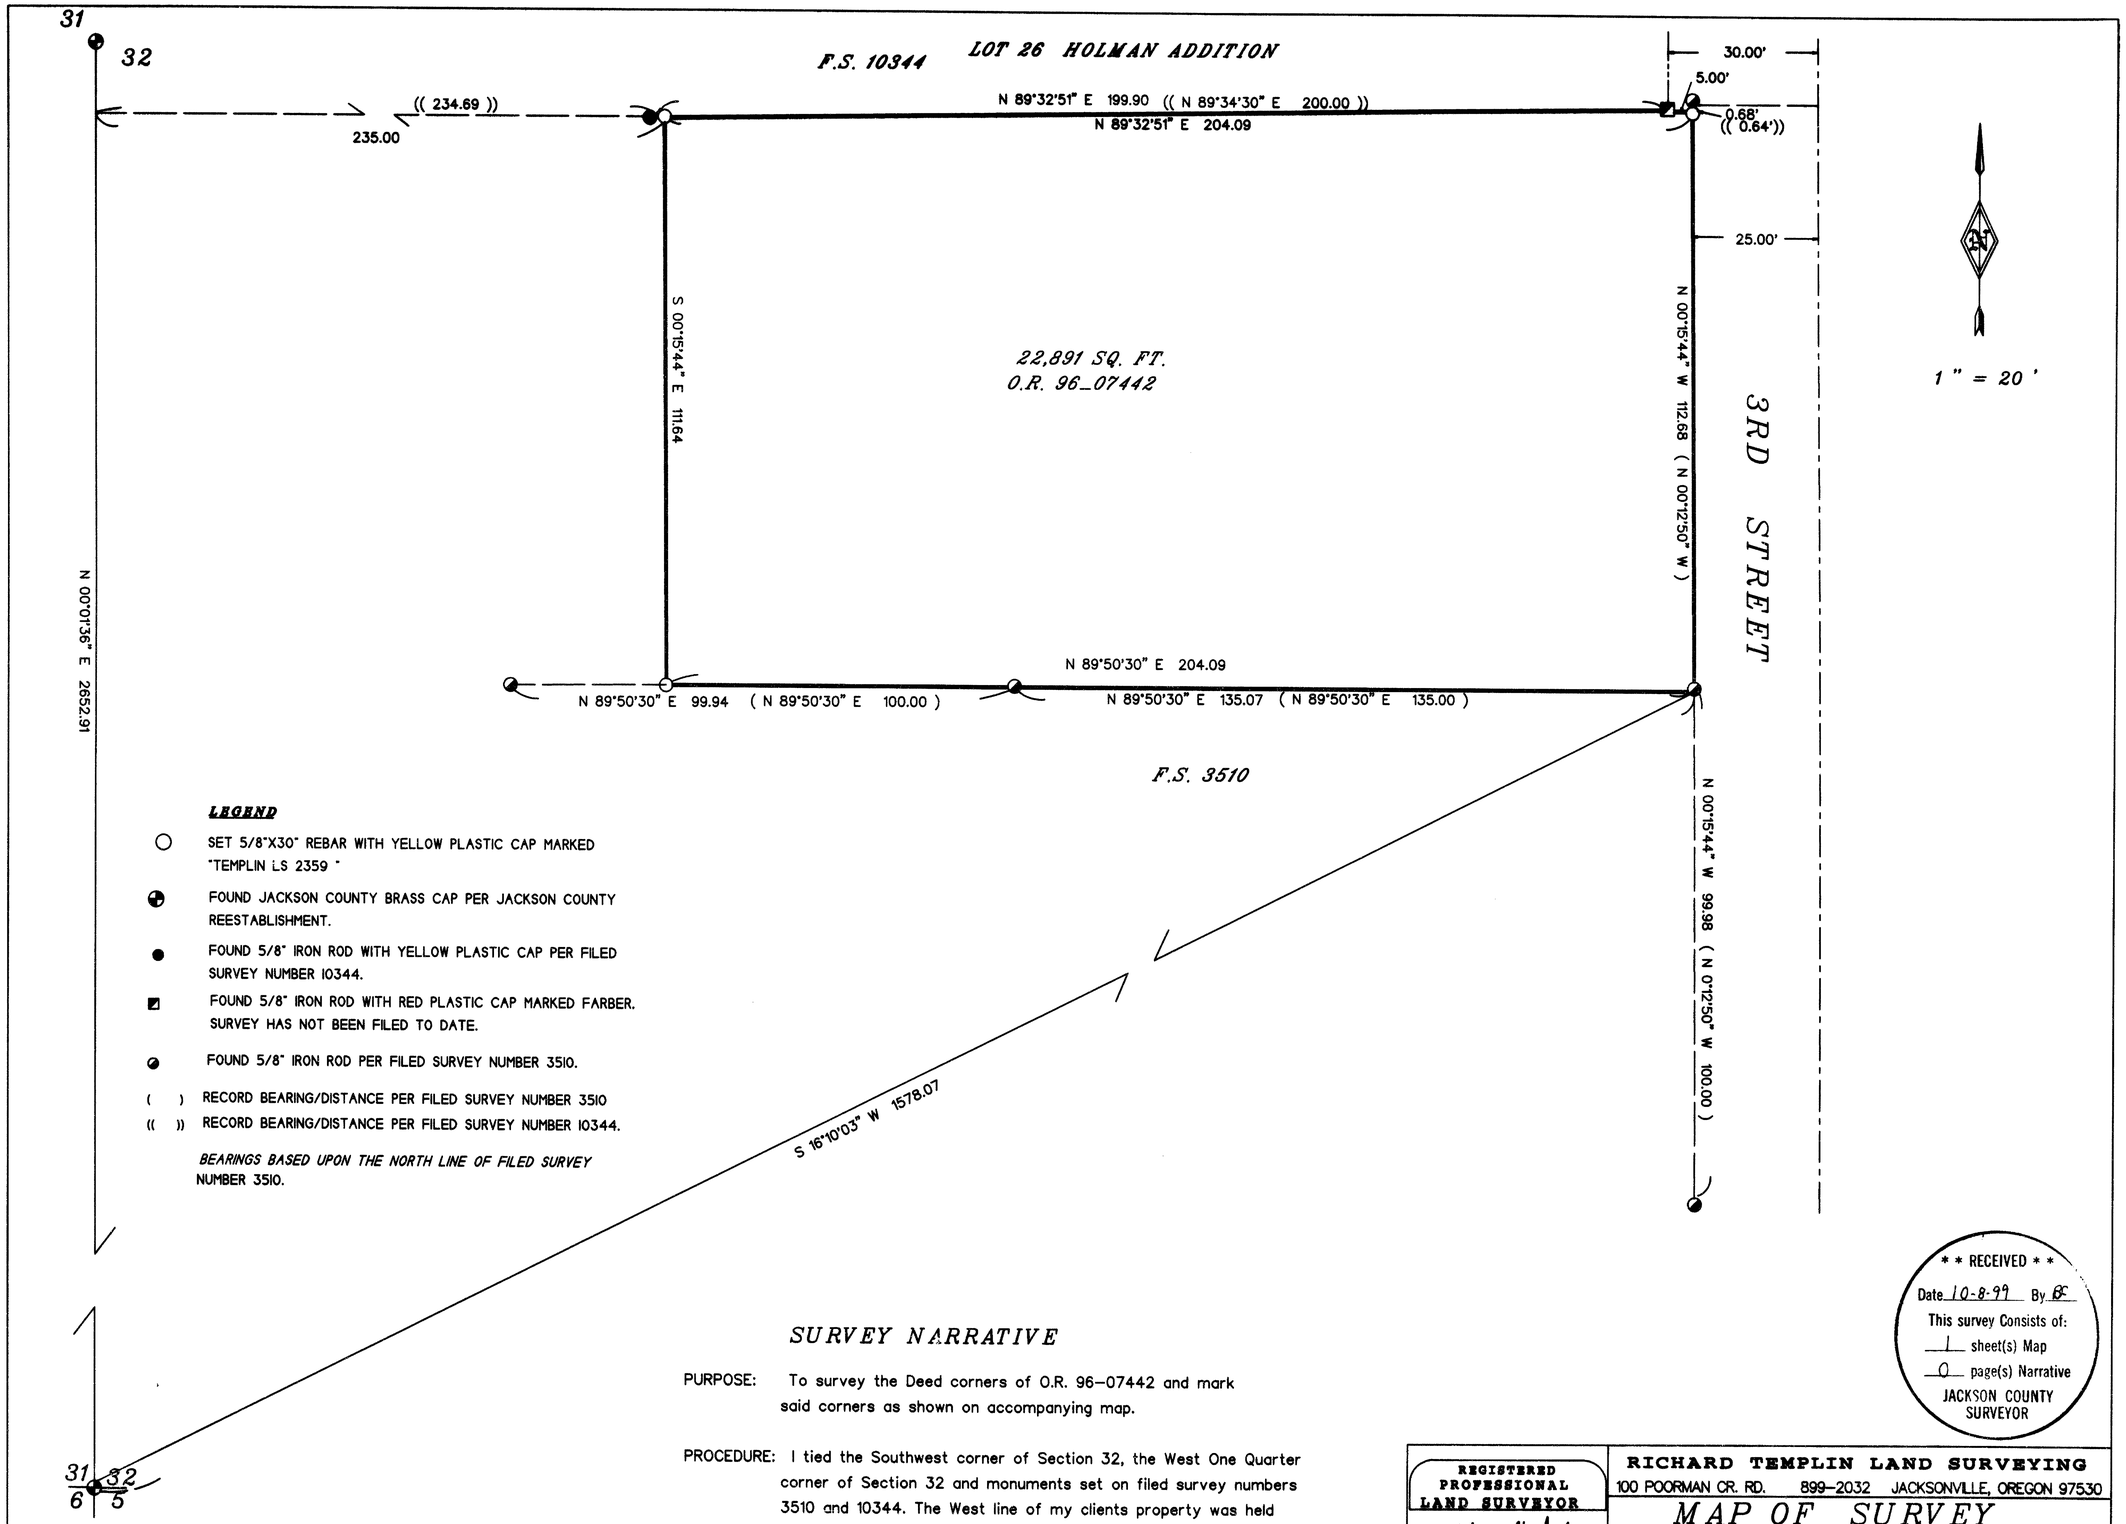

LEGEND

- ○ SET 5/8"X30" REBAR WITH YELLOW PLASTIC CAP MARKED "TEMPLIN LS 2359 "
- ⊕ FOUND JACKSON COUNTY BRASS CAP PER JACKSON COUNTY REESTABLISHMENT.
- ● FOUND 5/8" IRON ROD WITH YELLOW PLASTIC CAP PER FILED SURVEY NUMBER 10344.
- ◩ FOUND 5/8" IRON ROD WITH RED PLASTIC CAP MARKED FARBER. SURVEY HAS NOT BEEN FILED TO DATE.
- ◕ FOUND 5/8" IRON ROD PER FILED SURVEY NUMBER 3510.
- ( ) RECORD BEARING/DISTANCE PER FILED SURVEY NUMBER 3510
- (( )) RECORD BEARING/DISTANCE PER FILED SURVEY NUMBER 10344.

BEARINGS BASED UPON THE NORTH LINE OF FILED SURVEY NUMBER 3510.

SURVEY NARRATIVE

PURPOSE: To survey the Deed corners of O.R. 96–07442 and mark said corners as shown on accompanying map.

PROCEDURE: I tied the Southwest corner of Section 32, the West One Quarter corner of Section 32 and monuments set on filed survey numbers 3510 and 10344. The West line of my clients property was held 235.00 feet East of the West line of Section 32. The South line was established by filed survey number 3510. The North line was established by filed survey number 10344. I determined the deed corners positions and set monuments as shown.

* * RECEIVED * *
Date 10-8-99 By BC
This survey Consists of:
1 sheet(s) Map
0 page(s) Narrative
JACKSON COUNTY SURVEYOR

REGISTERED PROFESSIONAL LAND SURVEYOR
OREGON JULY 26, 1988 RICHARD G. TEMPLIN 2359
RENEWAL DATE: JUNE 30,00

RICHARD TEMPLIN LAND SURVEYING
100 POORMAN CR. RD. 899–2032 JACKSONVILLE, OREGON 97530

MAP OF SURVEY
LOCATED IN
THE SW 1/4 OF SECTION 31. T.37 S.. R.2 W.. W.M.
CITY OF JACKSONVILLE. JACKSON COUNTY. OREGON

SURVEYED FOR: Lois Sunyich
207 Rustic Canyon Dr.
Grants Pass. Or. 97526

DATE: October 5. 1999

37_2W_32CB_TL 3200