

REGISTERED OREGON LAND SURVEYOR

L. E. Ager
MARCH 10 1944
L. E. AGER
21

MAP OF SURVEY
FOR
PRUDENCE GREGORY, HOLLYWOOD, CALIFORNIA
LOCATED IN SECTIONS 30 & 31, T. 35 S. R. 1 W. W.M.
JACKSON COUNTY, OREGON
SOLAR BEARINGS

DATE: 8-1-60 SCALE: 1" = 400'

NOTE:
EXISTING FENCES
NOT ON TRUE LINE


Survey narrative to comply with (ORS 209.250) Oregon State Law of 1947

For: Prudence Gregory, Hollywood, California

Purpose: To establish the boundaries of tracts shown on accompanying Map.

Proceedure: Began survey at concrete monument on the township and range line and ran a random line north, tying to the original corners shown along the range line. The $\frac{1}{4}$ corner between Sections 31 & 30 fell in a cultivated field and no evidence of the original corner found. I prorated this in from the southwest corner to the northwest corner of Section 31, on true line which location fell $\frac{1}{2}$ feet west of old fence line, I set a $\frac{3}{4}$ " pipe 1' below the surface of the ground and set a reference pipe on the fence line $\frac{1}{2}$ ' east of corner. Other corners set as shown on the accompanying map according to the bearings and distances set forth.

REGISTERED
OREGON
LAND SURVEYOR

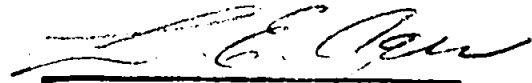

MARCH 10, 1944
L. E. AGER
21

