


16333

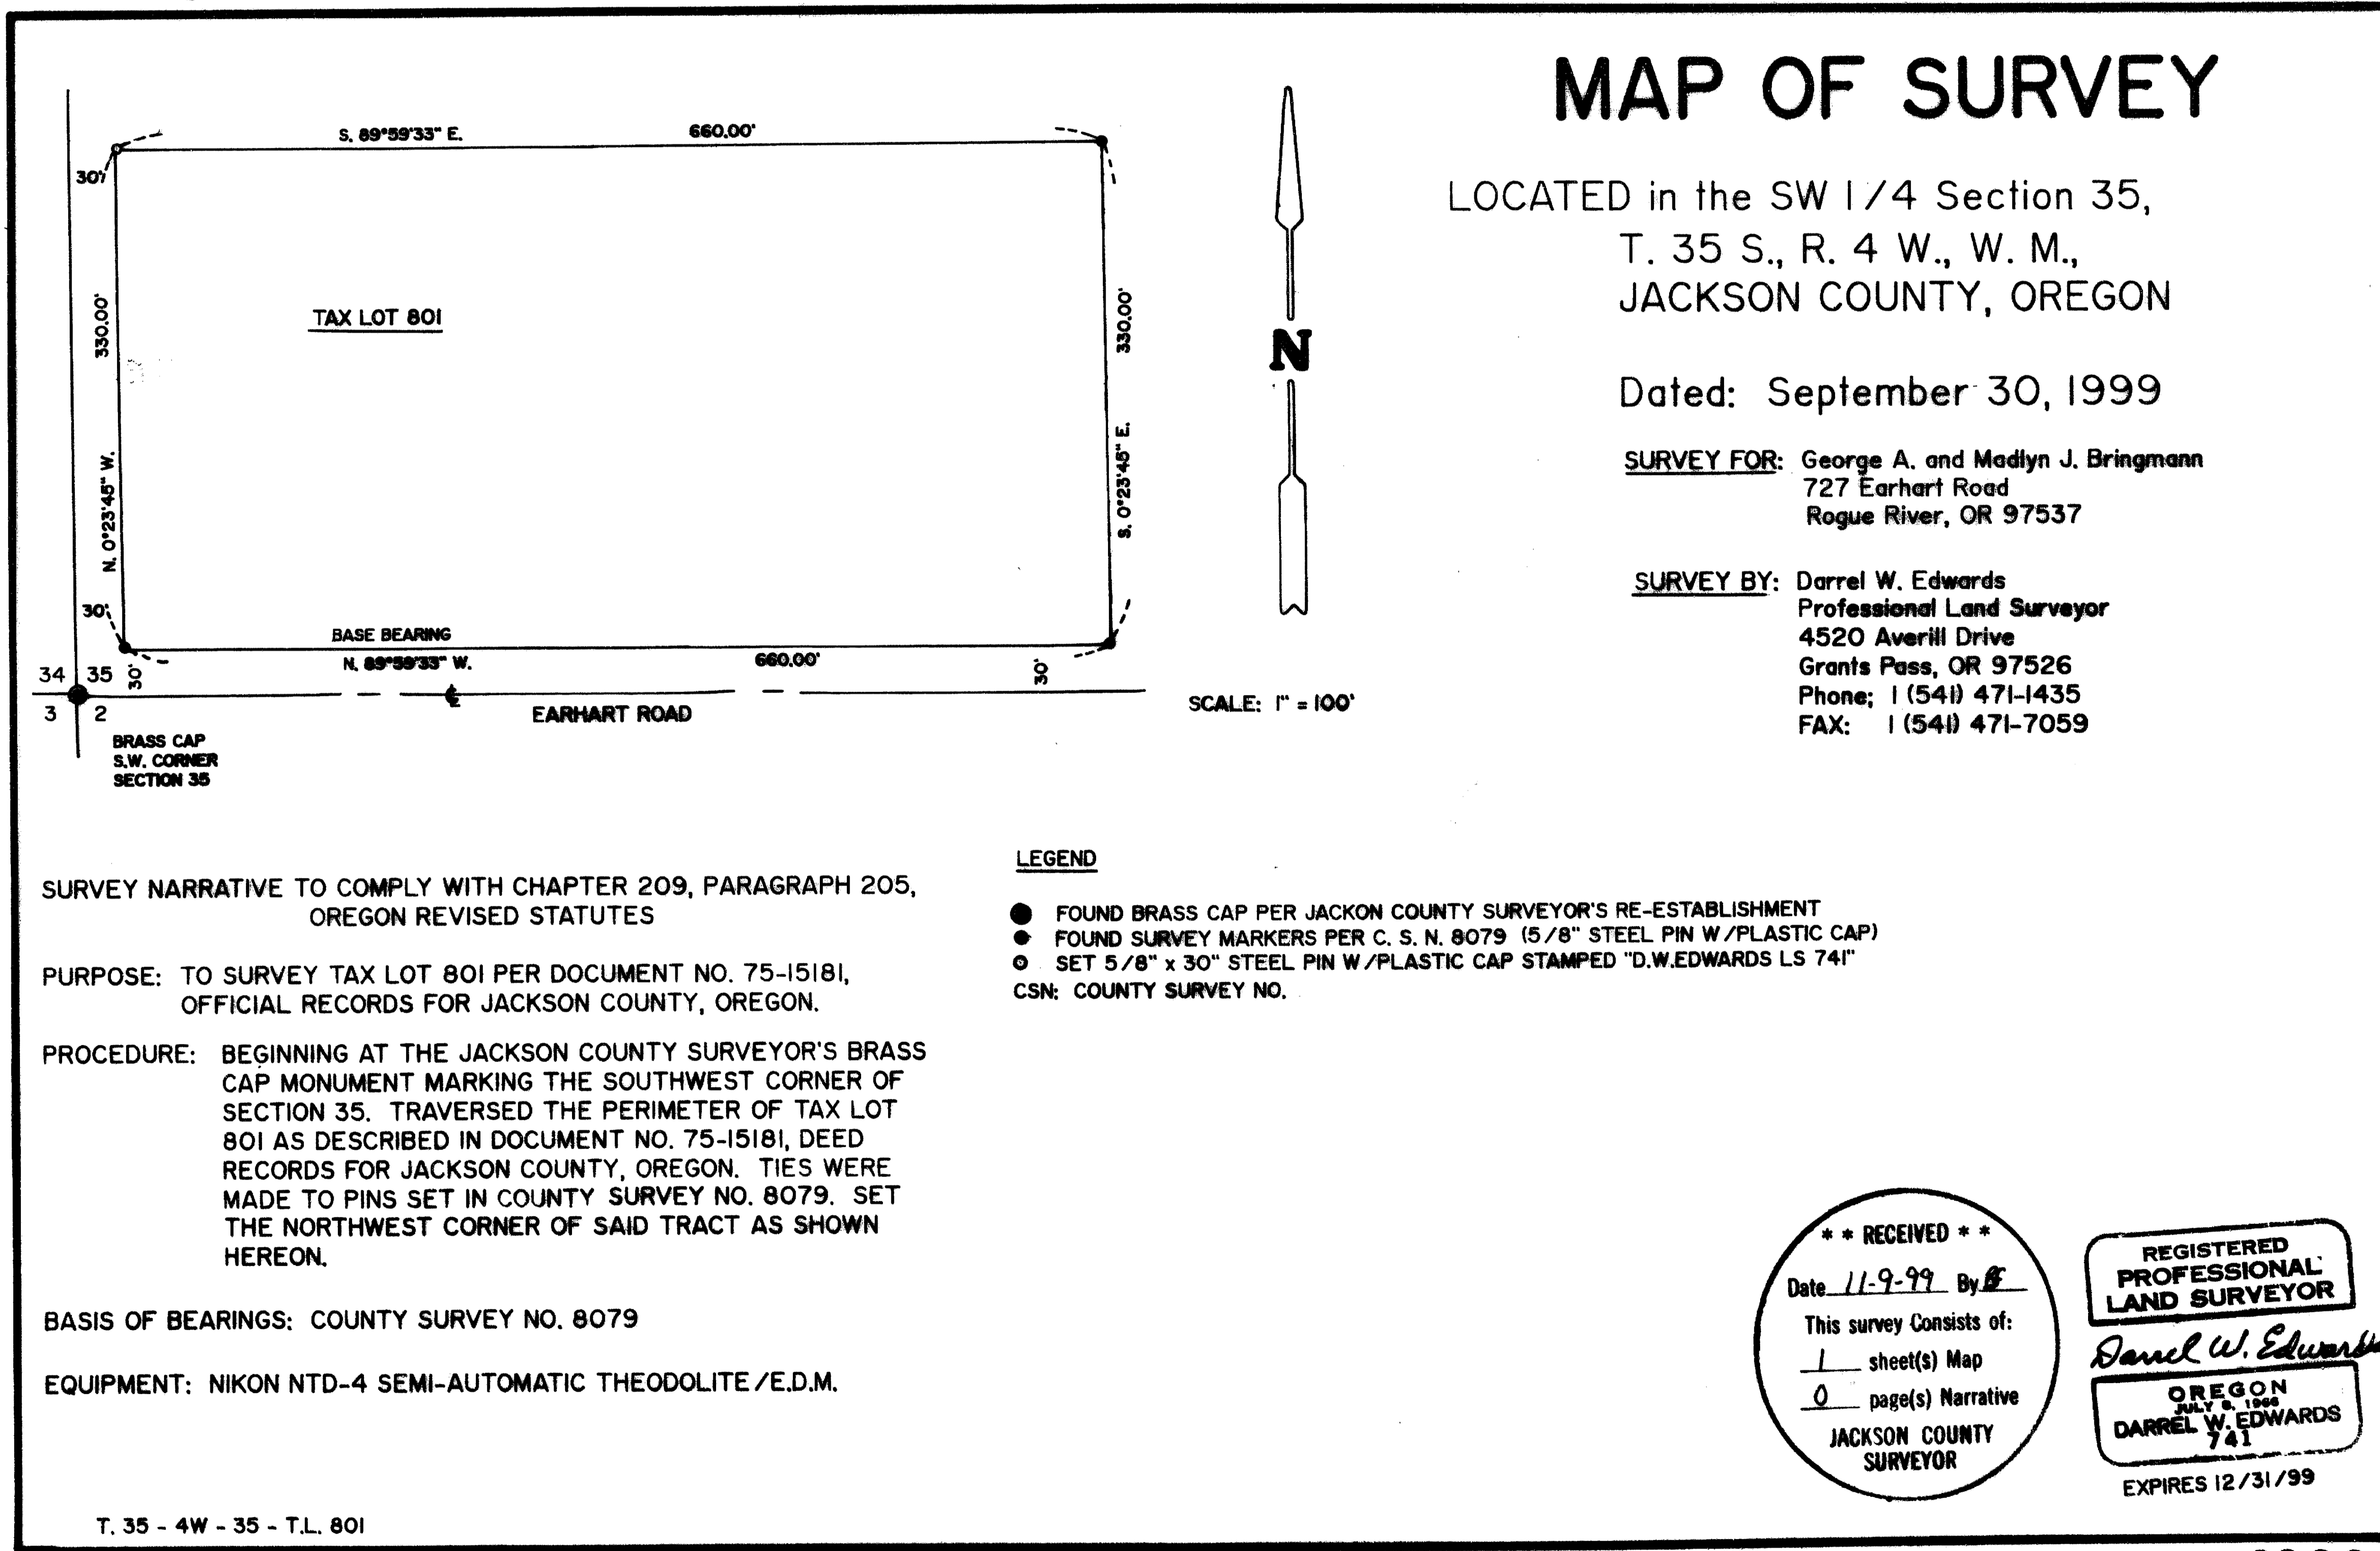

**** RECEIVED ****
Date 11-9-99 By DE
This survey consists of:
1 sheet(s) Map
0 page(s) Narrative
JACKSON COUNTY
SURVEYOR

REGISTERED
PROFESSIONAL
LAND SURVEYOR

Darrel W. Edwards

OREGON
JULY 9, 1998
DARREL W. EDWARDS
741

EXPIRES 12/31/99

16333