

SCALE 1"=40'

Basis of Bearings Sherman Heights Subd.

LEGEND

- = Set 5/8"x24" I. Pin (tagged P.L.S. 636)
- = Found 5/8" I. Pin
- O.R.J.C.O. = Official Records Jackson County Oregon

** RECEIVED **
 Date 12-1-99 By GP
 This survey consists of:
1 sheet(s) Map
1 page(s) Narrative
 JACKSON COUNTY
 SURVEYOR

REGISTERED
PROFESSIONAL
LAND SURVEYOR
George Burrell
 OREGON
 JULY 10, 1964
 GEORGE R. BURRELL
 636
 EXR12/31/99

APPROVAL:

 Jackson County Dept. of Planning
 FILE NO. 1999-459-PA
 11/29/99
 Date

MAP OF SURVEY
 Of Property Line Adjustment between Lots 4 and 5,
 Block 2 of SHERMAN HEIGHTS SUBD. in the S.W.1/4
 of Section 6, Township 38 South, Range 2 West, W.M.
 For: BARBARA DORSEY
 By: George Burrell, P.L.S.
 1379 Brookdale Ave. Medford, Oregon 97504
 Nov. 4, 1999

SURVEY NO. 16360

SURVEY NARRATIVE TO COMPLY WITH O.R.S. 209.250

FOR:

Barbara Dorsey
97 Andesite Drive
Jacksonville, OR 97530

LOCATION:

Lots 4 and 5, Block 2 of SHERMAN HEIGHTS SUBDIVISION in the S.W. 1/4 of Section 6, Township 38 South, Range 2 West

PURPOSE:


To monument and describe a property line adjustment between said lots 4 and 5

PROCEDURE:

The found monuments of said Subdivision were held as control for locating the adjusted property boundary according to the clients instructions and County Planning approval as shown on the accompanying map. The original 5/8" iron pin at the S.W. corner of said lot 4, has been destroyed by utility construction and was not remonumented by this survey.

BY:

George Burrell, PLS
1379 Brookdale Ave.
Medford, OR 97504
Nov. 4, 1999

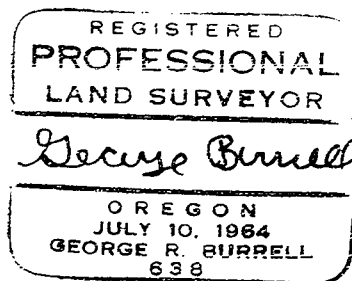

Exp. 12/31/99

