


MOST SOUTHERLY
CORNER OF BLOCK
27, PER FS 15181

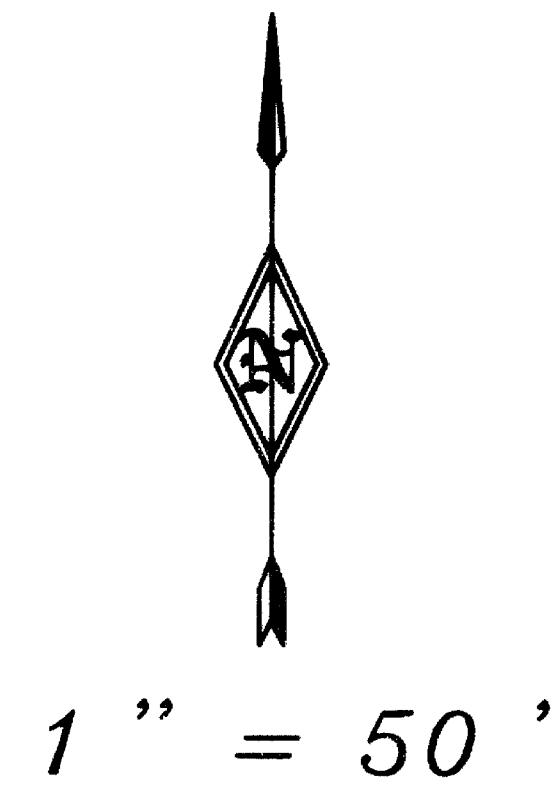

SURVEY NARRATIVE

PURPOSE: To survey the Deed corners of O.R. 99-56175 and mark said corners as shown on accompanying map.

PROCEDURE: I tied centerline monuments as depicted on the map hereon. I then computed the proportioned lot corners and set monuments as shown. The Lot corners set on filed survey number 7057 were searched for, but not found.

LEGEND

- SET 5/8"X30" REBAR WITH YELLOW PLASTIC CAP MARKED "TEMPLIN LS 2359"
 - 5/8" IRON ROD PER FILED SURVEY NUMBER 15161.
 - ⊙ 3/4" IRON ROD PER FILED SURVEY NUMBER 6701.
 - ⦿ 3/4" IRON ROD PER FILED SURVEY NUMBER 3579.
 - ⊕ 3/4" IRON ROD PER FILED SURVEY NUMBER 2436
 - ▲ 5/8" IRON ROD. ORIGIN UNKNOWN.
 - △ CALCULATED POSITION
 - () RECORD BEARING/DISTANCE PER ORIGINAL PLAT.
- BEARINGS BASED UPON FILED SURVEY NUMBER 7057.

** RECEIVED **
Date: JAN 17, 2000 By: [Signature]
This survey consists of:
1 sheet(s) Map
0 page(s) Narrative
JACKSON COUNTY SURVEYOR

37_2W_32BD_TL 4100

* DUBOIS.GCD*

REGISTERED PROFESSIONAL LAND SURVEYOR OREGON JULY 26, 1988 RICHARD G. TEMPLIN 2359 RENEWAL DATE: JUNE 30, 00	RICHARD TEMPLIN LAND SURVEYING 100 POORMAN CR. RD. 899-2032 JACKSONVILLE, OREGON 97530 MAP OF SURVEY LOCATED IN LOTS 5, 6 AND A PORTION OF LOT 7, BLOCK 31, ORIGINAL CITY OF JACKSONVILLE, JACKSON COUNTY, OREGON SURVEYED FOR: Mr. Georges Du Bois 4132 Livingston Rd. Jacksonville, Or. 97530 DATE: December 28, 1999
---	---