

MAP OF SURVEY
 located in
 SOUTHEAST ONE QUARTER OF SECTION 31
 TOWNSHIP 37 SOUTH, RANGE 2 WEST
 WILLAMETTE MERIDIAN, JACKSON COUNTY, OREGON
 for **WHETSTONE***
BRUCE AND JAN WHETSTONE
 P. O. BOX 1990
 JACKSONVILLE, OREGON 97530
 * AFFIDAVIT OF CORRECTION
 Doc. No. 00-10163 (SN 16447)
 R. ROBERTS, C.S. 03/17/00

LEGEND

- ⊗ = FOUND 5/8 INCH SMOOTH IRON PIN (UNKNOWN SURVEY) OR AS DESCRIBED
- = FOUND 5/8" IRON PIN, L.S. 262 S/N 2036
- = FOUND 5/8" IRON PIN w/ YELLOW PLASTIC CAP MARKED "ANDREWS PLS 1626" - NOT OF RECORD -
- = SET 5/8" x 24" IRON PIN w/ YELLOW PLASTIC CAP MARKED "FARBER PLS 2189"
- ⊙ = FOUND 3/4 INCH IRON PIPE SET OVER 5/8 INCH IRON PIN

S/N = RECORD FILED SURVEY NUMBER
 W.C. = WITNESS CORNER

- BASIS OF BEARING IS TRUE NORTH, NAD 83/91 DATUM, AS DERIVED BY GLOBAL POSITIONING SYSTEM OBSERVATIONS.
 - RECORD SURVEY DATA IS SHOWN IN PARENTHESIS ADJACENT TO MEASURED SURVEY DATA WHERE APPLICABLE. PER RECORD SURVEY No. 2036

** RECEIVED **
 Date March 2, 2000 By CJD
 This survey consists of:
1 sheet(s) Map
0 page(s) Narrative
 JACKSON COUNTY
 SURVEYOR

**REGISTERED
 PROFESSIONAL
 LAND SURVEYOR**
Herbert A. Farber
OREGON
 JULY 26, 1985
 HERBERT A. FARBER
 2189
 RENEWAL DATE 12-31-01

**SURVEY NARRATIVE
 TO COMPLY WITH O.R.S. 209.250**

PURPOSE: TO RETRACE AND MONUMENT PROPERTY BOUNDARIES FOR TAX LOTS 1200, 1201, 1202 AND 1203. PER INSTRUMENT No. 98-20075 OF THE OFFICIAL RECORDS OF JACKSON COUNTY, OREGON.

PROCEDURE: UTILIZING CONTROL ESTABLISHED ON SEVERAL SURVEYS IN THE AREA THE MONUMENTS SHOWN HEREON WERE TIED IN CLOSED TRAVERSE. THE MONUMENTS ESTABLISHED ON FILED SURVEY No. 2036 WERE FOUND TO BE WITHIN ACCEPTABLE POSITIONS. THE MONUMENTS FOUND NOT OF RECORD FIT THE DEED RECORD LOCATION AND WERE THERE FOR HELD AT THE FOUND POSITIONS. THE MONUMENT ESTABLISHED ON THIS SURVEY WAS PLACED AT THE DEED RECORD LOCATION.

Surveyed by:
FARBER & SONS, INC.
 dba FARBER SURVEYING
 (541) 776-0846

OFFICE LOCATION: 120 MISTLETOE MEDFORD, OREGON 97501
 MAILING ADDRESS: P.O. BOX 5286 CENTRAL POINT, OREGON 97502

SCALE: 1" = 60'
 DATE: FEBRUARY 23, 2000
 JOB NO. 0743-98
 DRAWING FILE: JOBS\HILLST\BASEMAP.FLX

00-10163

16447

3:44

5
11

AFFIDAVIT OF CORRECTION

I, Herbert A. Farber, a registered Professional Land Surveyor in the State of Oregon, having surveyed the tract for Bruce and Jan Whetstone filed as Survey No. 16447 in records of the County Surveyor, Jackson County, Oregon, acknowledge the following drafting error in said Survey:

The name WHETSONE should read WHETSTONE.

This affidavit is to comply with Chapter 92.170 of the Revised Statutes of the State of Oregon


Herbert A. Farber
Herbert A. Farber

March 17, 2000

State of Oregon)
)SS
County of Jackson)

Personally appeared the above named, Herbert A. Farber, and acknowledged the foregoing to be his voluntary act and deed.

Before me: 3-17-00 Susan Morgan Farber

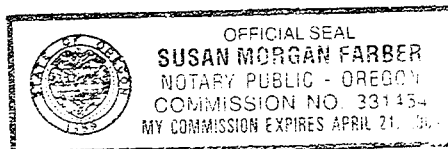

Examined and approved this 17th day of March, 2000.

Roger Roberts
Jackson County Surveyor

Jackson County, Oregon
Recorded
OFFICIAL RECORDS

MAR 17 2000

3:44 pm
Susan Morgan Farber
COUNTY CLERK

