16531

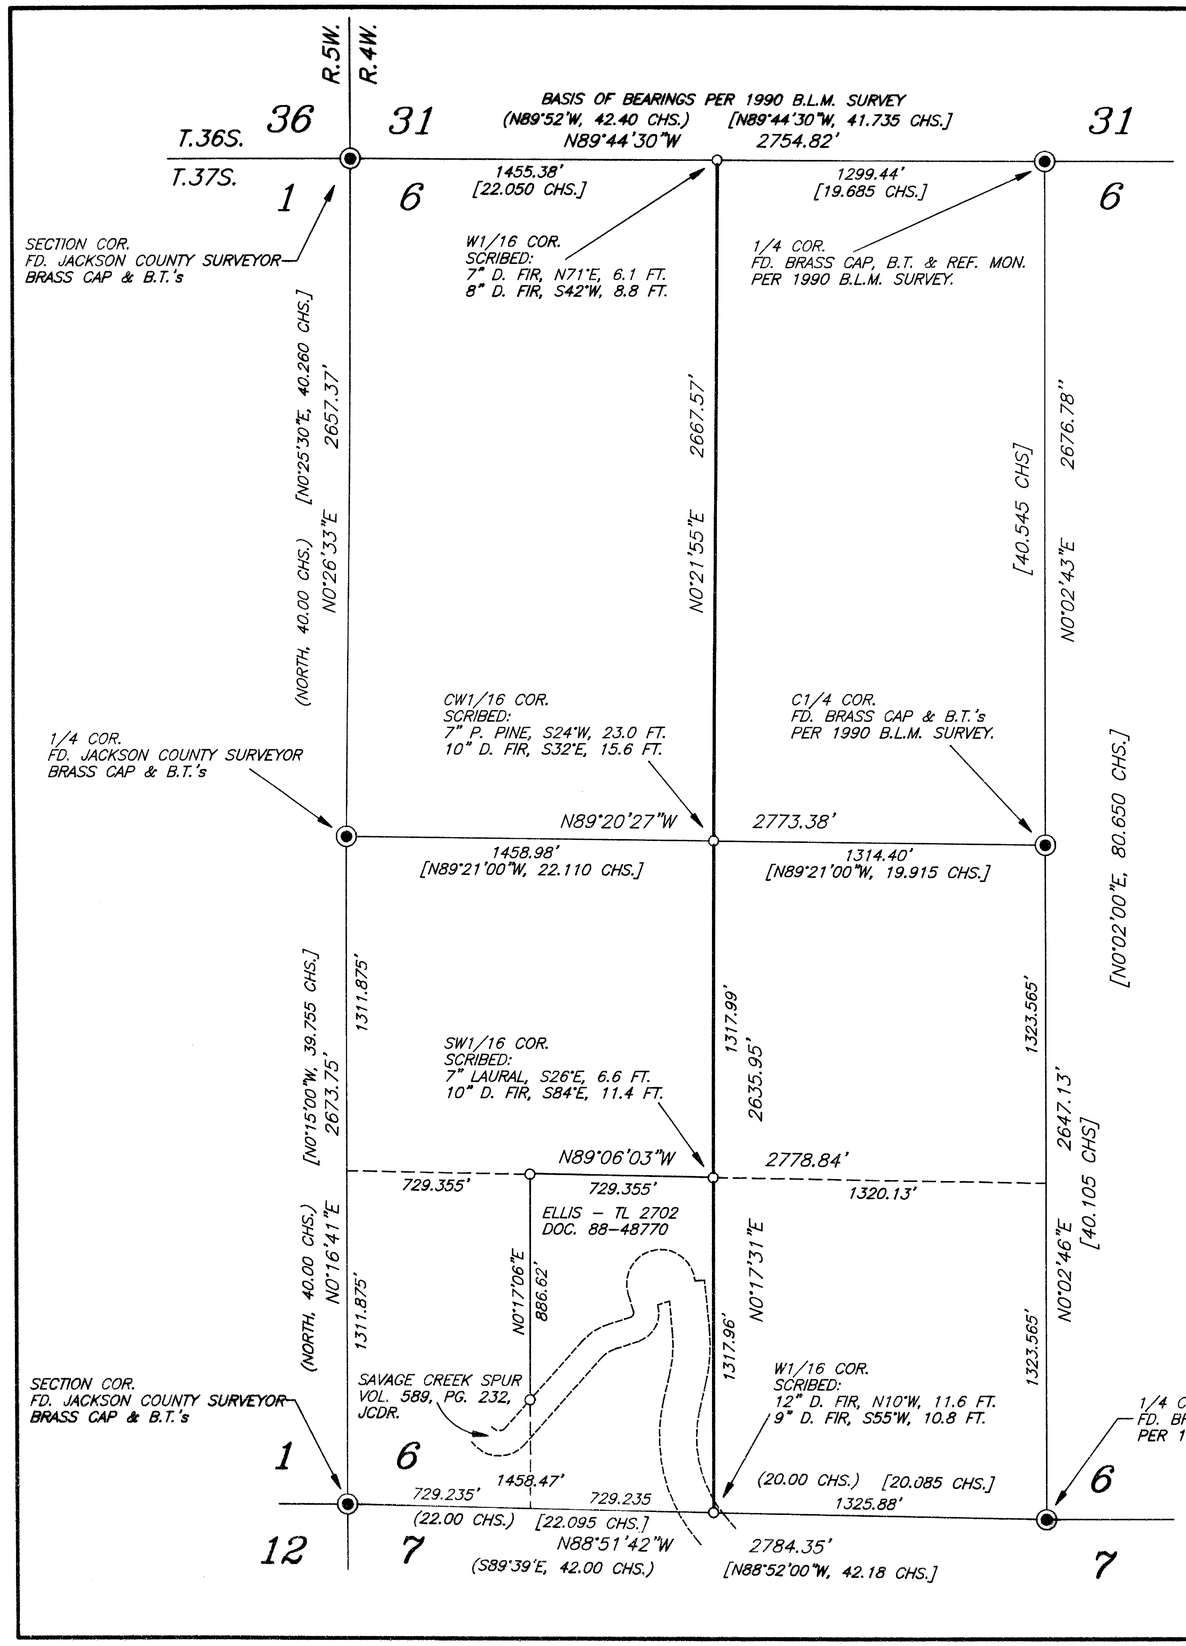

PLAT

SHOWING A SURVEY IN THE W1/2 OF SECTION 6, T.37S., R.4W., W.M., JACKSON COUNTY, OREGON.

N

LEGEND

- ○ SET 5/8" X 30" IRON ROD WITH YELLOW PLASTIC CAP MARKED "NYGREN LS1035".
- ◉ FOUND BRASS CAP MONUMENT.
- ——— MARKED LINE WITH BLAZES PAINTED FLO-RED AND FLO-RED RIBBON.
- ( ) RECORD PER ORIGINAL G.L.O. SURVEY.
- [ ] RECORD PER 1990 B.L.M. SURVEY.

BEARINGS BASED ON 1990 B.L.M. SURVEY.

SURVEY NARRATIVE

THE PURPOSE OF THIS SURVEY IS TO ESTABLISH THE WEST ONE-SIXTEENTH CORNER ON THE NORTH LINE, THE CENTER-WEST ONE-SIXTEENTH CORNER AND THE WEST ONE-SIXTEENTH CORNER ON THE SOUTH LINE, ALL IN SAID SECTION 6, AND MARK LINE BETWEEN THEM FOR LOGGING. IN THE PROCESS OF DOING THIS SURVEY, I WAS COMMISSIONED BY KEVIN ELLIS, THE OWNER OF TAX LOT 2702, TO SET THE SOUTHWEST ONE-SIXTEENTH CORNER OF SAID SECTION 6, WHICH IS THE NORTHEAST CORNER OF SAID TAX LOT 2702, AND ALSO SET THE NORTHWEST AND SOUTHWEST CORNERS OF SAID TAX LOT 2702.

SECTION 6 WAS SURVEYED AND SUBDIVIDED BY THE BUREAU OF LAND MANAGEMENT IN 1990. FOR CONTROL I RECOVERED AND HELD TO MONUMENTS SET PER THE 1990 BUREAU OF LAND MANAGEMENT SURVEY AND MONUMENTS SET PER THE JACKSON COUNTY SURVEYOR'S OFFICE, WHICH WERE FOUND AS SHOWN ON ANNEXED PLAT.

A NIKON DTM-A20LG TOTAL STATION WAS USED TO EXECUTE THIS SURVEY.

REGISTERED PROFESSIONAL LAND SURVEYOR
OREGON
GERALD V. NYGREN
AUGUST 22, 1975
1035
EXPIRES 12-31-2000

RECEIVED
Date May 30, 2000 By CJD
This survey Consists of:
1 sheet(s) Map
0 page(s) Narrative
JACKSON COUNTY SURVEYOR

SURVEYED FOR:	GERALD V. NYGREN	DATE: APRIL 21, 2000
SPALDING & SON, INC.	522 BARKER DRIVE	SCALE: 1" = 400'
P.O. BOX 438	MERLIN, OREGON 97532	JOB NO. 00-29
GRANTS PASS, OR 97526-0240		

16531