


PLAT
 SHOWING A SURVEY SITUATED IN THE SW1/4
 OF SECTION 13, T.37S., R.4W., W.M., JACKSON
 COUNTY, OREGON.

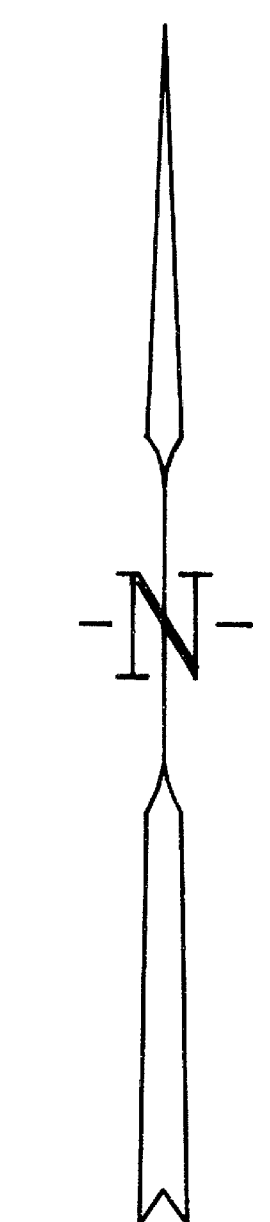

LEGEND

- SET 5/8" X 30" IRON ROD WITH YELLOW PLASTIC CAP MARKED "NYGREN LS1035".
 - FOUND MONUMENT AS NOTED.
 - MARKED LINE WITH STAKES & FLO-RED RIBBON.
 - () RECORD PER SURVEY NO. 5678.
 - [] COMPUTED DATA.
- BEARINGS BASED ON SURVEY NO. 5678.

SURVEY NARRATIVE

THE PURPOSE OF THIS SURVEY IS TO SET THE SOUTHWEST ONE-SIXTEENTH CORNER OF SECTION 13 AND MARK THE SOUTH LINE OF THE NORTHEAST QUARTER OF THE SOUTHWEST QUARTER OF SAID SECTION 13 FROM THE SOUTHWEST ONE-SIXTEENTH CORNER EASTERLY TO WHERE SAID SOUTH LINE INTERSECTS THE CENTERLINE OF EAST FORK FOOTS CREEK.

I RECOVERED AND HELD TO MONUMENTS SET PER SURVEY NO. 787, SURVEY NO. 5678 AND THE JACKSON COUNTY SURVEYOR, WHICH WERE FOUND AS SHOWN ON THE ANNEXED PLAT. THENCE I SUBDIVIDED THE SOUTHWEST QUARTER OF SAID SECTION 13 AND SET MONUMENTS AS SHOWN ON ANNEXED PLAT.

A NIKON DTM-A20LG TOTAL STATION WAS USED TO EXECUTE THIS SURVEY.

REGISTERED
 PROFESSIONAL
 LAND SURVEYOR

 OREGON
 GERALD V. NYGREN
 AUGUST 22, 1975
 1035
 EXPIRES 12-31-2000

**** RECEIVED ****
 Date: July 16, 2000 By: GJD
 This survey consists of
 1 sheet(s) Map
 0 page(s) Narrative
 JACKSON COUNTY
 SURVEYOR

SURVEYED FOR: LARRY OSBORN 4761 FOOTS CREEK RD. GOLD HILL, OR 97525	GERALD V. NYGREN 522 BARKER DRIVE MERLIN, OREGON 97532	DATE: MAY 26, 2000 SCALE: 1" = 200' JOB NO. 00-46
--	---	---