


1659

SURVEY FOR MRS. N.E. JUDY
 R4 BOX 360 MEDFORD, OREGON.
 Date Feb. 25, 1961
 Located in Sec. 24, T. 37S.R.2W.
 Jackson County, Oregon.

Record N2376 & E 2718.95
 from S.W. Cor. D.L.C. 88 T37S.R.2W.

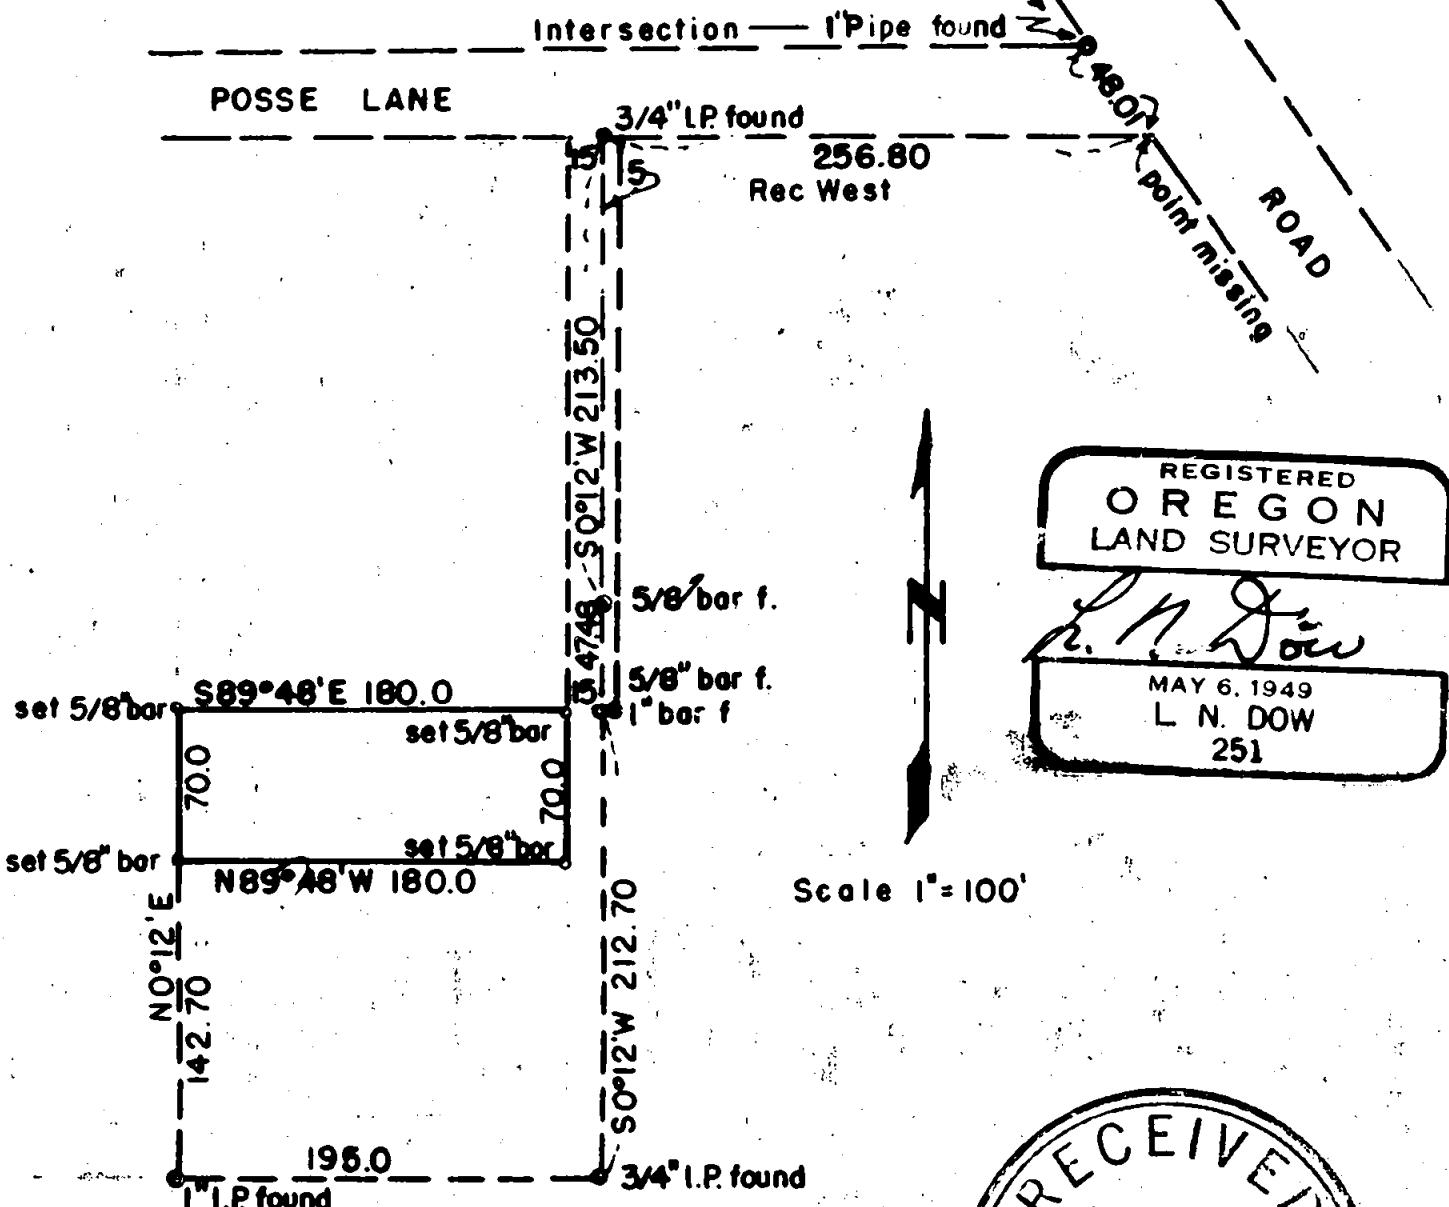

1659

1659

Written narrative to accompany plat for Survey NC.

Survey for Mrs. N.E. Judy, R 4 Box 360, Medford, Oregon.

Date of Survey February 25, 1961.

Located in Section 24, T. 37 S. R 2 W. Jackson County, Oregon.

Purpose, to set corners for 70 x 180 foot tract.

Procedure:

From a 1" iron pipe on the west line of Sage Road at the intersection of the north line of Posse Lane, ran southerly along the westerly line of Sage Road S 35°08'E 48.01 feet to locate corner mentioned in deed description. This corner is not there at this time, we then ran Deed Record West 256.80 and located a 3/4" iron pipe, then ran deed record S 0° 12'W 213.50 and found a 5/8" bar, thence continued S 0° 12'W 47.48 feet to a 5/8" bar; Continuing S 0° 12'W 212.70 and found a 4/3" pipe at the southeast corner of the tract being surveyed; then ran N 89°48'W 195.0 feet to a 1" pipe at the southwest corner, we then looked for the northwest corner which was missing.

Using the controls for the tract as described above we set 5/8" iron bars at the corners of the 70 x 180 foot tract as shown on the plat.



L. N. Dow

MAY 6, 1949
L. N. DOW
251

