
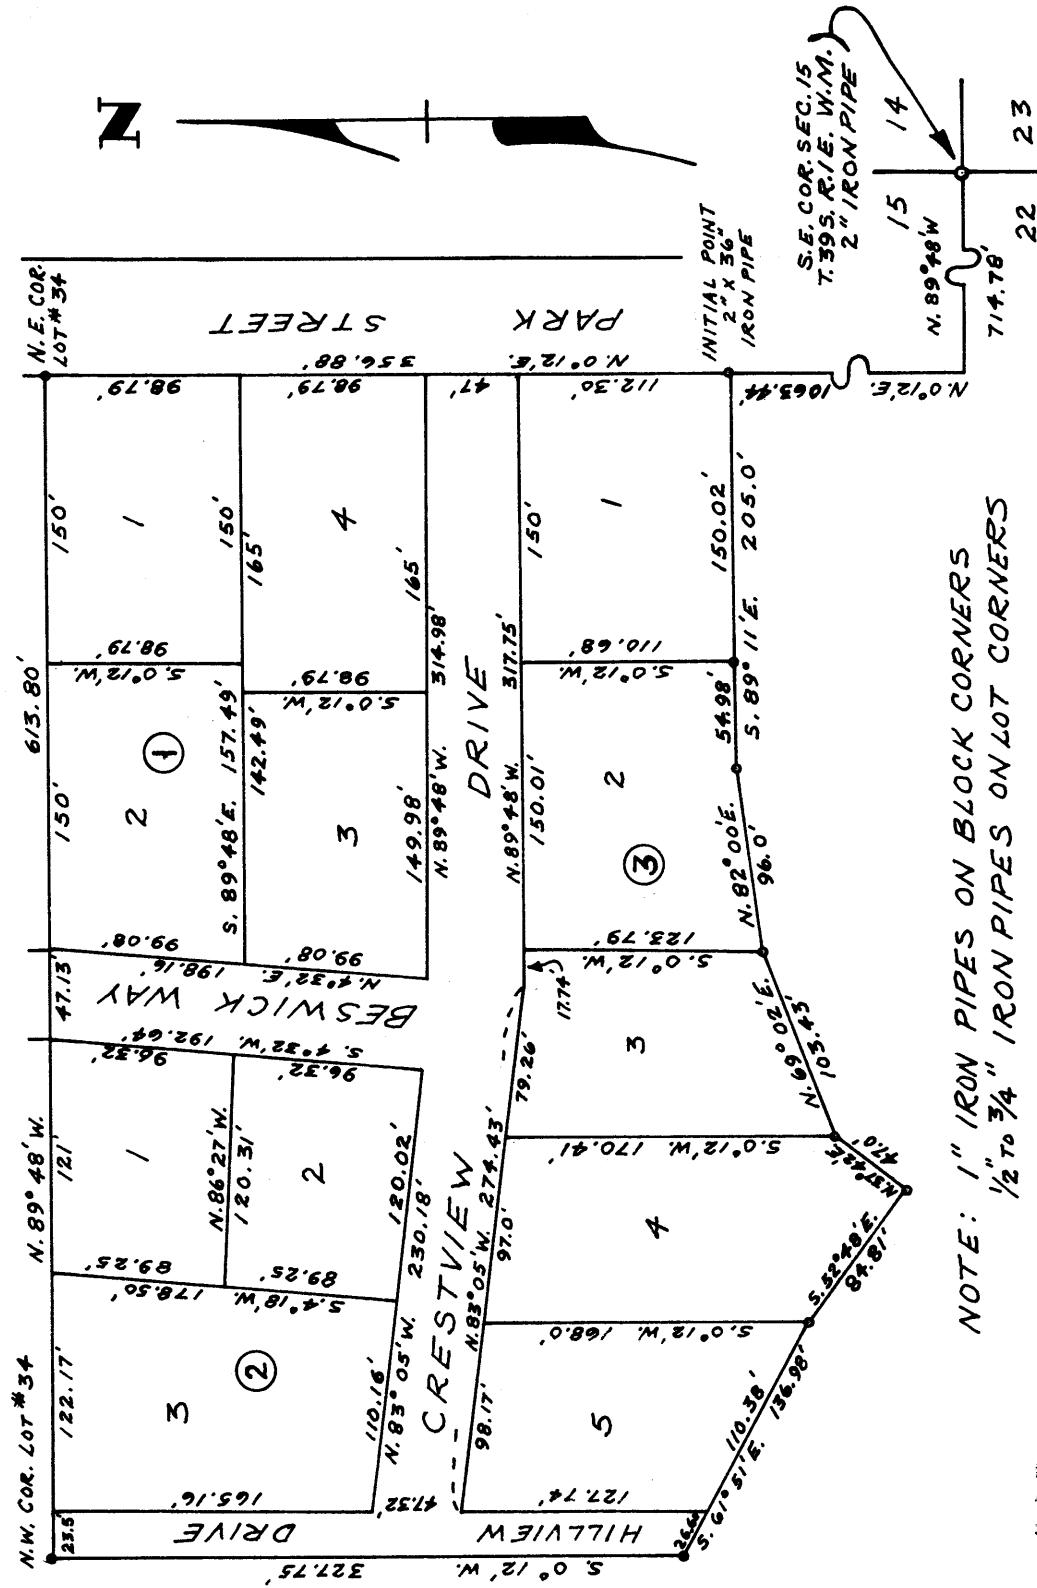
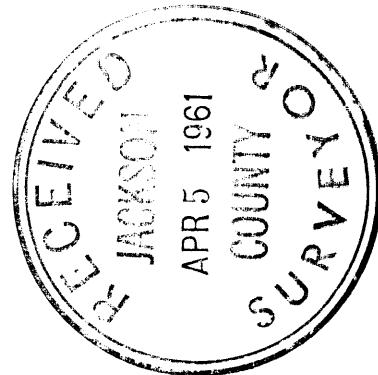


NORWOOD SUBDIVISION
MAP OF SURVEY

VERNON E. NORWOOD 1121 PARK ST., ASHLAND, OREGON
IN SECTION 15, T. 39 S. R. 1 E., W. M. JACKSON COUNTY, OREGON
MARCH 28, 1961
SCALE: 1" = 100'

SOLAR DATUM

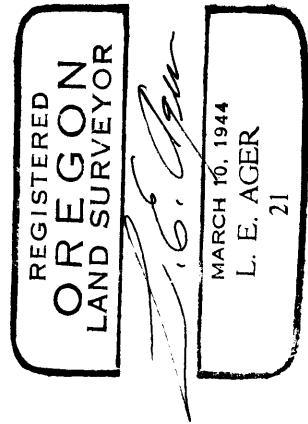

NOTE: 1" IRON PIPES ON BLOCK CORNERS

Survey narrative to comply with ORS 209.250, Oregon State Law of 1947

For: Vernon E. Horwood, 1121 Park St. Ashland, Oregon

Purpose: To include this tract in a platted & recorded Subdivision

Procedure: As this subdivision is a portion of Lots 33 & 3 $\frac{1}{4}$ of the platted Bellview Tracts and the corners of these Lots have been set by prior surveys, began my survey at the northwest corner of Lot 3 $\frac{1}{4}$ which was marked with a $\frac{1}{2}$ " iron rod, which I replaced with a 1" iron pipe and using the other corners of lots 33 & 3 $\frac{1}{4}$, which are marked with iron pipes for the basis of my boundary survey and I surveyed and marked the corners of the lots and blocks shown on this map according to the bearings and distances set forth.

