

## **LEGEND**

- O SET 5/8" X 30" IRON ROD WITH YELLOW PLASTIC CAP MARKED "NYGREN LS1035".
- FOUND MONUMENT AS NOTED. BEARINGS BASED ON SUR. NO. 16531.


## SURVEY NARRATIVE

THE PURPOSE IS TO MONUMENT A PROPOSED BOUNDARY LINE ADJUSTMENT ON LINE COMMON TO PARCELS OF LAND DESCRIBED IN DOC. 83-08179 (TAX LOT 2601) AND DOC. NO. 85-07953 (TAX LOT 2602), JACKSON COUNTY RECORDS, AS DIRECTED BY MY CLIENT, WILLIAM D. KETTLER, AND AS SHOWN ON ANNEXED MAP.

I RECOVERED AND HELD TO MONUMENTS SET PER SUR. NO. 16531, SUR. NO. 16557, AND THE JACKSON COUNTY SURVEYOR'S OFFICE, WHICH WERE FOUND AS SHOWN ON ANNEXED MAP. THENCE I SET MONUMENTS AS SHOWN ON ANNEXED MAP.

SAVAGE CREEK ROAD LOCATION AND WIDTH WAS DETERMINED USING INFORMATION RECORDED IN VOLUME 239, PAGE 631, JACKSON COUNTY RECORDS.

A NIKON DTM-A20LG TOTAL STATION WAS USED TO EXECUTE THIS SURVEY.

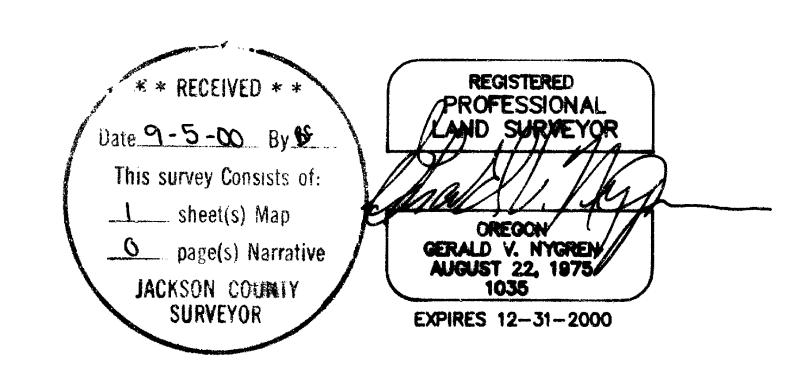

SURVEYED FOR:

WILLIAM D. & LYNDA A. KETTLER 1195 SAVAGE CREEK ROAD GRANTS PASS, OR 97527

GERALD V. NYGREN 522 BARKER DRIVE MERLIN, OREGON 97532

DATE: JULY 18, 2000 SCALE: 1" = 100' JOB NO. 00-41

MAP 37-04W-6, TL's 2601 & 2602

16651