

37 2W 13DC TL 1800



MARK E. BOYDEN

108 MISTLETOE ST., MEDFORD, OREGON 97501 PHONE (503) 773-6000

SURVEY NO

16678

SURVEY NARRATIVE TO COMPLY WITH O.R.S. 209.250

SURVEY FOR:

The Salvation Army

1065 Crews Road

Medford, OR 97501

&

Brenda C. Watkins, Loving Trust

c/o Brenda C. Watkins, Trustee

1059 Crews Road Medford, OR 97501

SURVEY BY:

Boyden Surveyors 108 Mistletoe Street

Medford, OR 97501

LOCATION:

Blocks 2 & 3, JOHN R. CREWS SUBDIVISION (Recorded)

in the SE 1/4 of Section 13, T. 37 S., R. 2 W., W.M.

City of Medford, Jackson County, Oregon

BASIS OF

BEARINGS:

West boundary of D.L.C. No. 61, according to County Filed

Survey No. 8175.

DATE:

July 5, 2000

PURPOSE:

To monument and prepare a map of the tract proposed to be

conveyed to the Salvation Army by the Brenda C. Watkins,

Loving Trust.

Also prepared Resultant descriptions of the Watkins Trust &


Salvation Army tracts after the Property Line Adjustment has been

recorded.

PROCEDURE: Enclosed the area of JOHN R. CREWS SUBDIVISION lying Northeasterly from the 16-foot wide alley in Block 2 of said subdivision, by closed E.D.M. traverse. Tied to original subdivision monuments and monuments found or set on County Recorded Survey Nos. 7655, 8175 & 14835.

From said data, monumented the desired tract to be conveyed to the Salvation Army at positions shown on the map to accompany this report.

Inquiry with the City Surveyor indicated that no field notes could be found for that tract described in Instrument No. 75-13448 of the Official Records of said County.

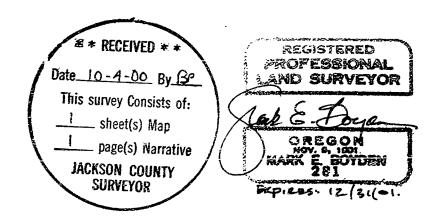

