




## SURVEY NARRATIVE TO COMPLY WITH O.R.S. 209.250

FOR: Medford Irrigation District  
1310 Barnett Road  
Medford, Oregon

PURPOSE: To monument and describe 2 parcels with roadway easements to be deeded to the Medford Irrigation District, being located in DLC #42, Sec. 15, T38SR1W.

PROCEDURE: Found previously set monuments found on Recorded Survey No. 1091. Also found 1" iron pipes previously set on the partitionment of the Colver property, which monuments are referred to in Volume 215, page 171 of the Deed Records of Jackson County, Oregon. Also tied in the centerline of Interstate Highway No. 5 and the "L" corner of DLC #42 to close-loop this survey with Recorded Survey No. 1091. From this basic information, calculations were made to the 1" iron pipes found to verify their positions, using a meridian equasion of  $0^{\circ} 03' 30''$  clockwise from deed record bearings.

April 1961

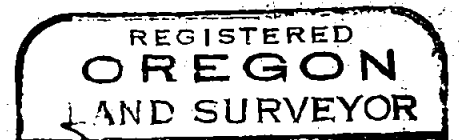

*Mark E. Boyden*  
NOVEMBER 9, 1951  
MARK E. BOYDEN  
281