


16820

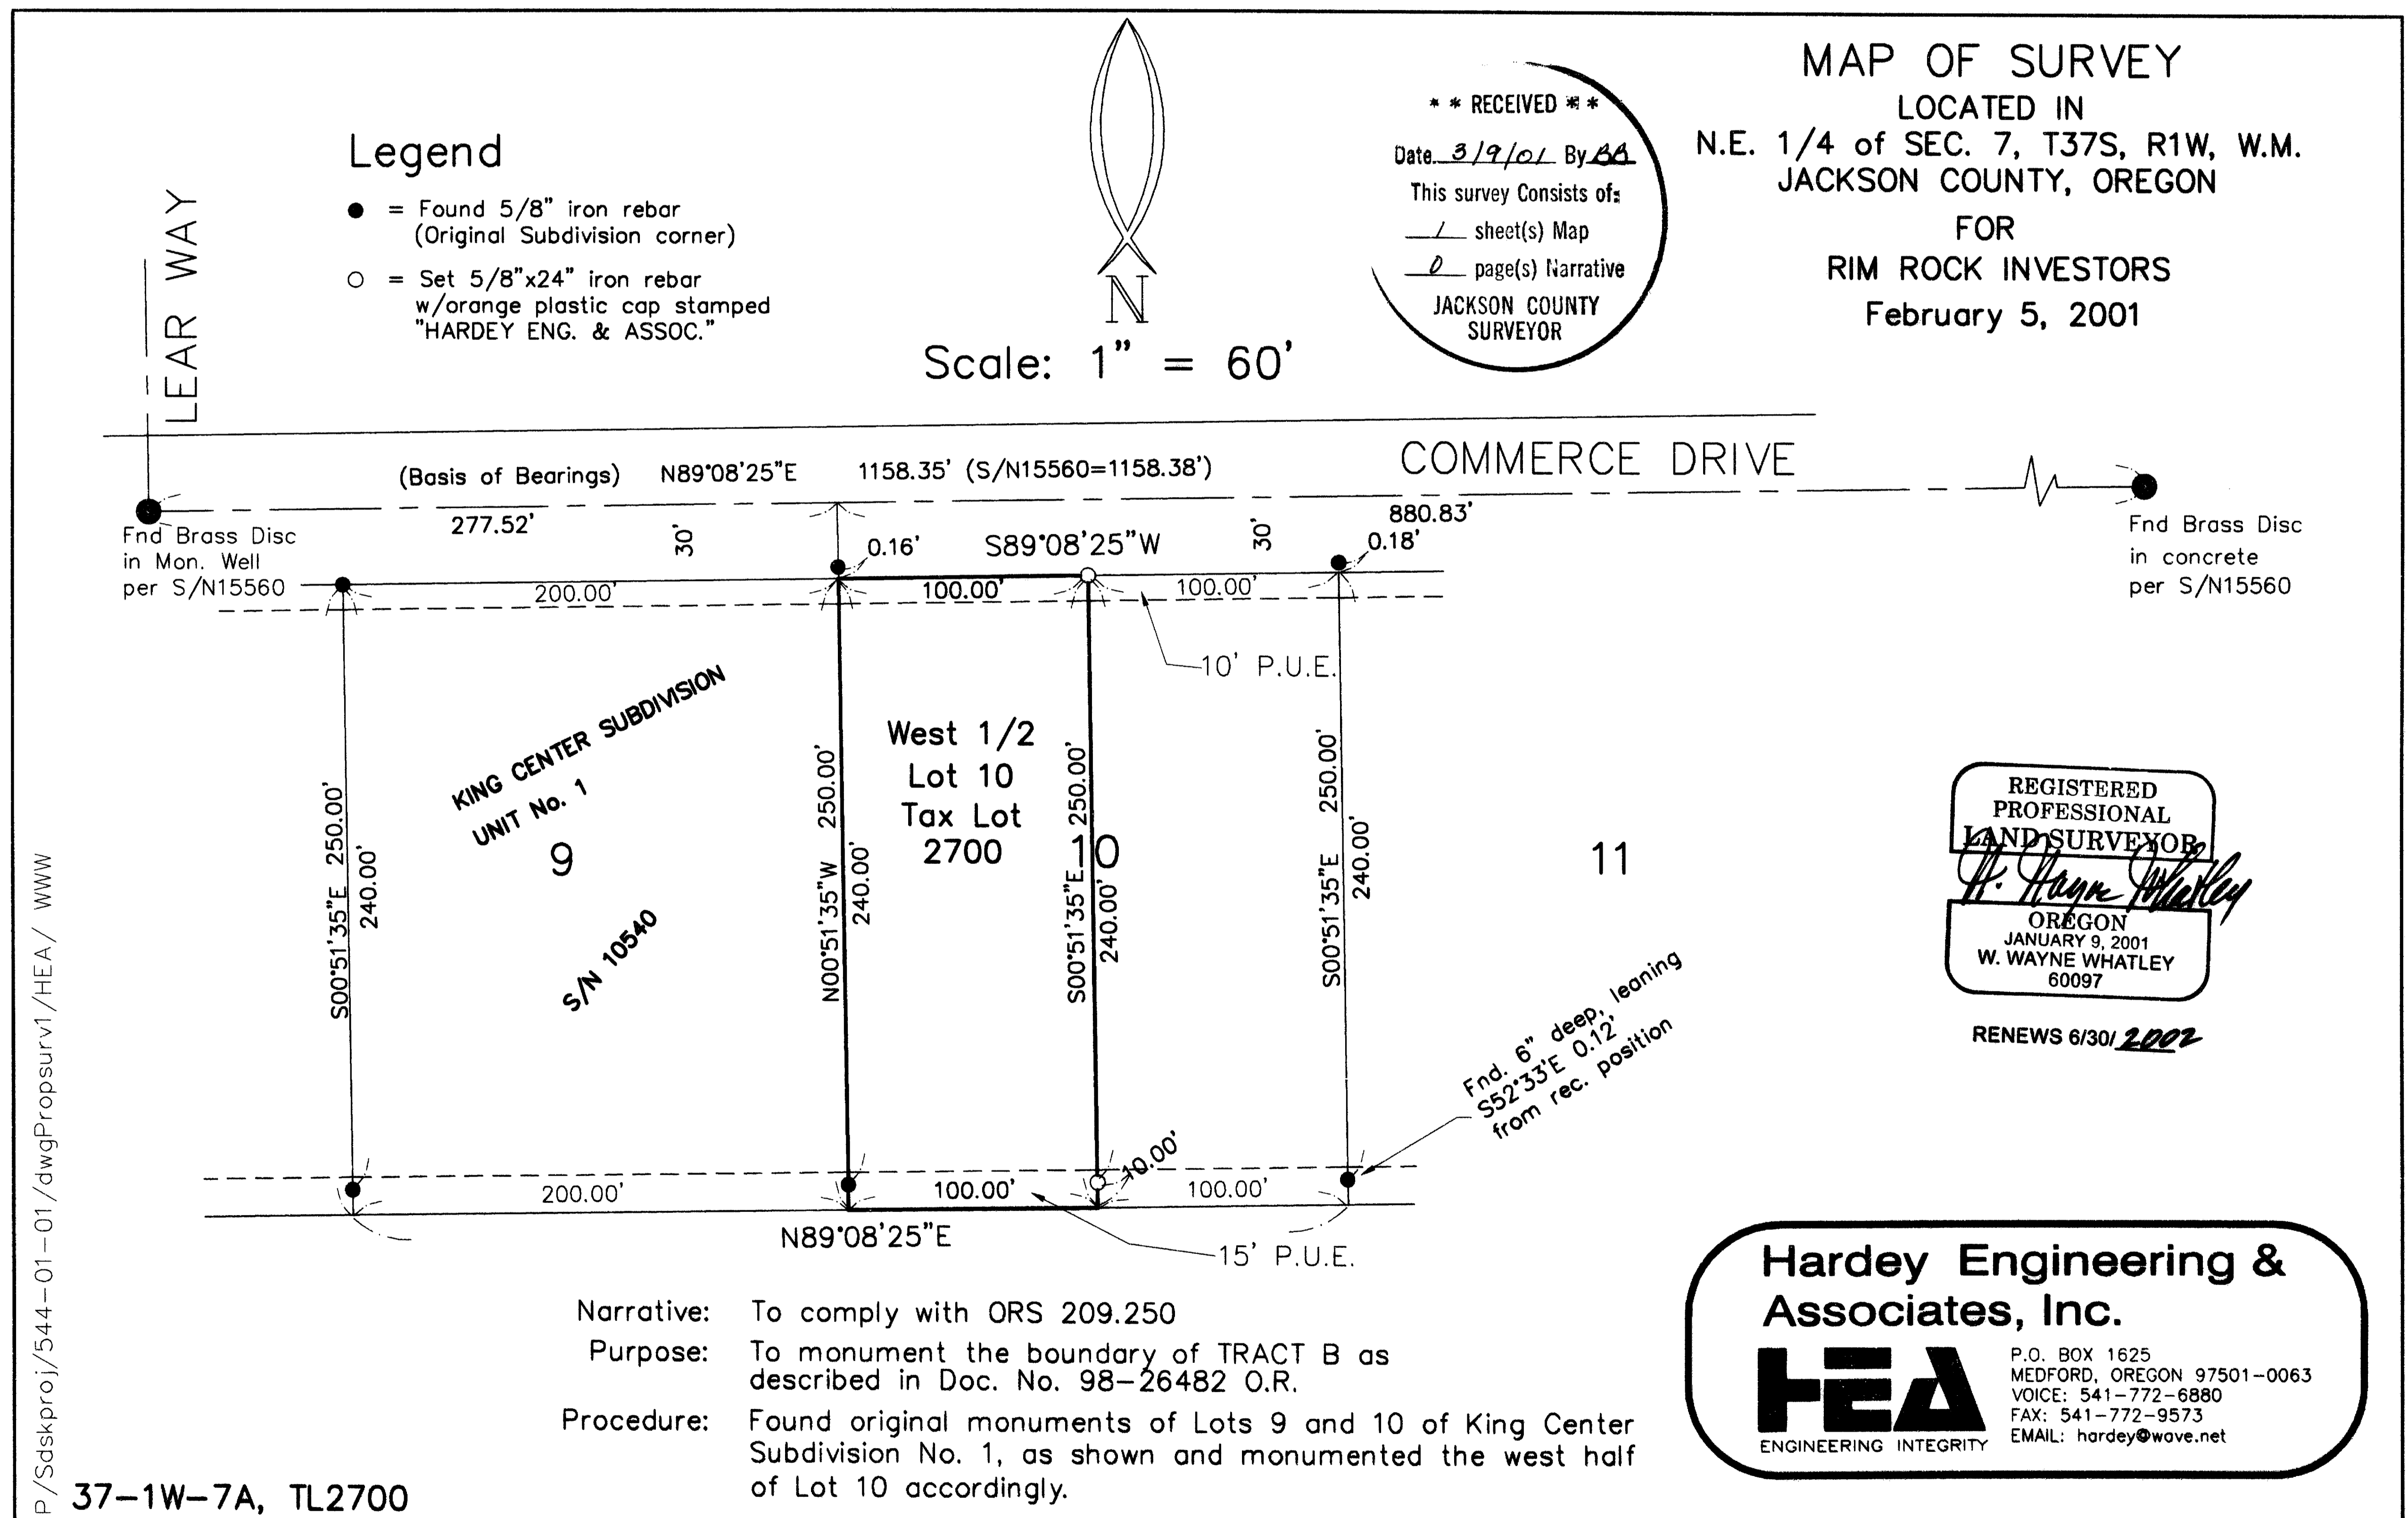

16820