16825

MAP OF SURVEY
FOR
ALEX KNECHT

P.O. BOX 3209
ASHLAND, OREGON 97520

LOCATED IN

The N.E. 1/4 of Section 15, T.39S., R.1E., W.M.
City of Ashland, Jackson County, Oregon

** RECEIVED **
Date 3/9/01 By
This survey Consists of:
1 sheet(s) Map
0 page(s) Narrative
JACKSON COUNTY SURVEYOR

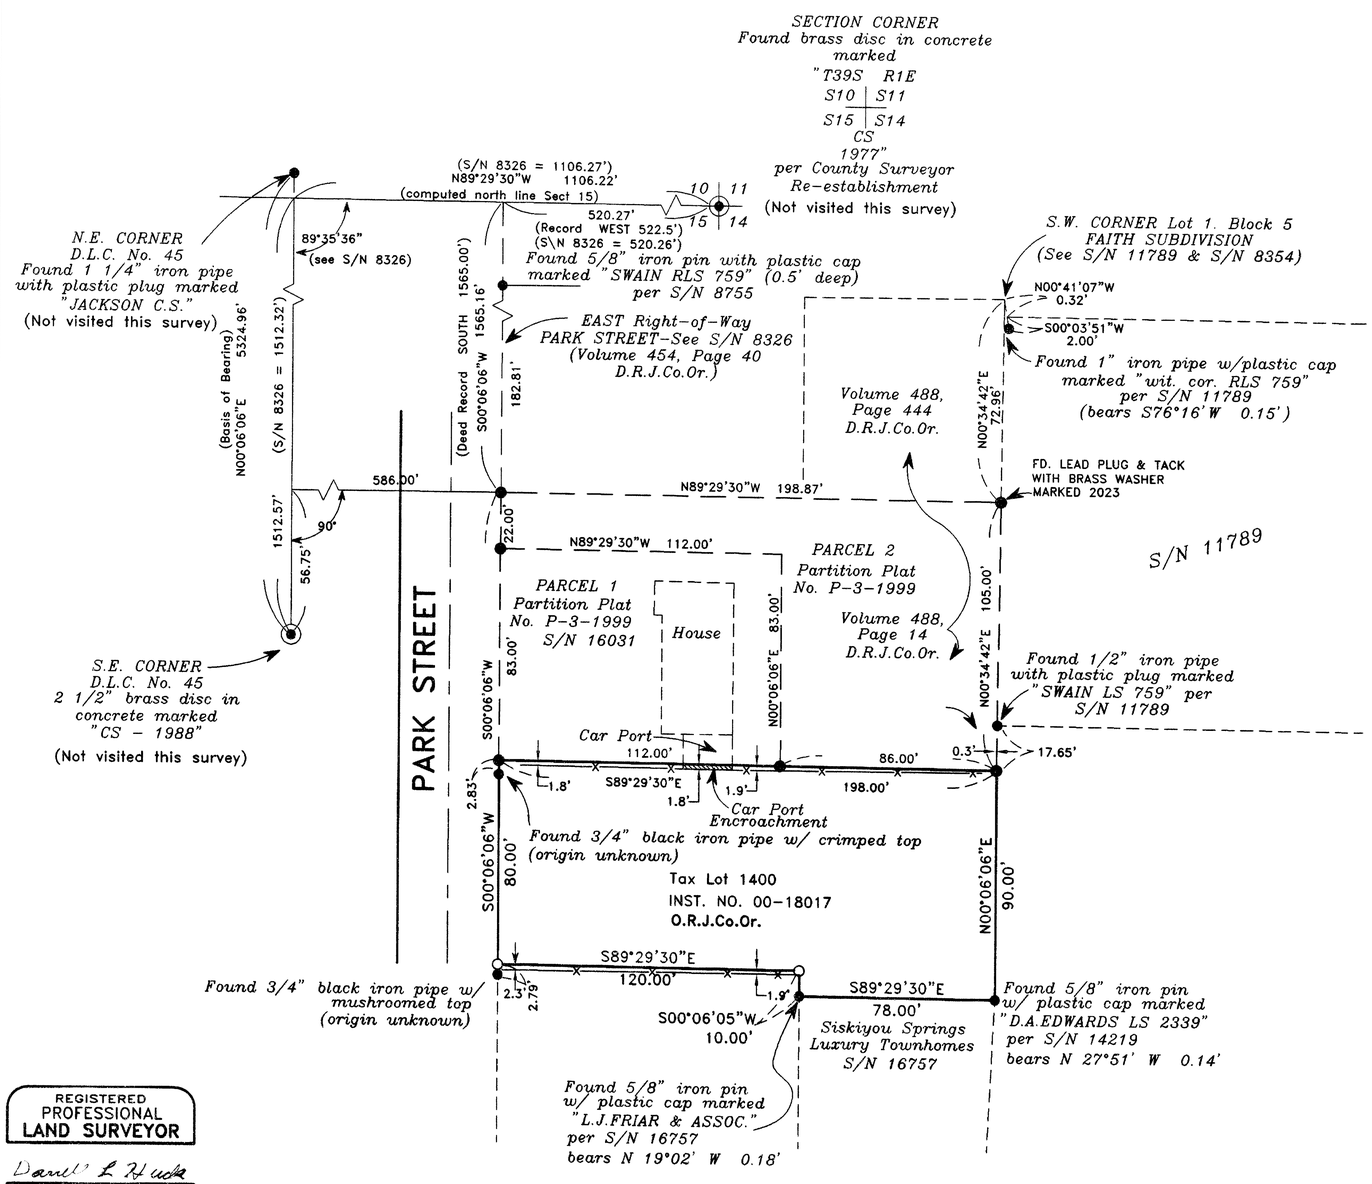

SURVEY NARRATIVE TO COMPLY WITH PARAGRAPH 209.250
OREGON REVISED STATUTES

PURPOSE:

To survey and monument a portion of the South boundary of that tract of land described in Instrument No. 00-18017, Official Records,Jackson County, Oregon.

PROCEDURE:

Control established by this office to accomplish Filed Survey No. 16031 was utilized for purposes of this survey. The survey narrtive of Survey No. 16031 is, by reference, incorporated herein. Based on the established control, the location of the two deed corners to be monumented was computed according to deed description and monuments were set as shown.

HOFFBUHR & ASSOCIATES, INC.
1062 E. JACKSON STREET MEDFORD, OREGON
(541)779-4641

BY: DARRELL L. HUCK PLS No. 2023
SCALE: 1 inch = 40 feet July 28, 1998
BASIS OF BEARING: N.O.A.A. TRUE MERIDIAN at the North-South Centerline of Section 15, The reference bearing for this survey is the East line of D.L.C. No. 45 as shown on Survey No. 8326

○	=	Set 5/8"x24" iron pin with plastic cap stamped "D. Huck LS 2023" unless noted otherwise
●	=	Found 5/8" iron pin w/ plastic cap marked "D.Huck L.S. 2023" per S/N 16031, unless unless noted otherwise.
◉	=	Found brass cap monument
S/N	=	Filed Survey Number
D.R.J.Co.Or.	=	Deed Records, Jackson County, Oregon
O.R.J.Co.Or.	=	Official Records, Jackson County, Oregon
—x—x—x—	=	Fence line

REGISTERED
PROFESSIONAL
LAND SURVEYOR
Darrell L. Huck
OREGON
FEBRUARY 4, 1983
DARRELL L. HUCK
2023
Expires 6/30/2001

39 1E 15AD, TL 1400

01031MOS.DWG

16825