


N.W. COR. OF EAST 1/2 D.L.C. #49
 T.38S, R.2W, W.M.
 FD. 7/8" I. PIN W/"X"

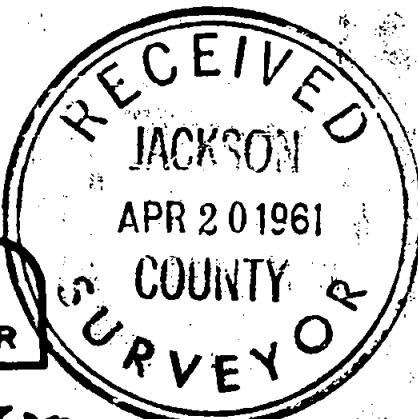

REGISTERED
OREGON
 LAND SURVEYOR

Leland P. Lovejoy

NOVEMBER 18, 1949
 LELAND P. LOVEJOY
 262

BOUNDARY SURVEY OF PROPERTY
 SITUATE IN
 SECTION 12, T.38S, R.2W, W.M.
 JACKSON COUNTY, ORE.
 FOR
 C.W. AND MILDRED HOLMES

L.P. LOVEJOY L.S. MEDFORD, ORE.
 SCALE 1" = 50' APRIL 15, 1961

BEARINGS BY PREVIOUS SURVEY
 W.C. = WITNESS CORNER
 ○ = SET 5/8" STEEL PIN

Survey Narrative to Comply with Section 87-3301947 Oregon State Laws

Survey for: C. W. and Mildred Holmes
Dark Hollow Road
Medford, Oregon

Purpose of Survey: To establish property boundaries of
land sold.

Survey Location: Sec. 21, T. 38 S., R. 2 W., W. M.,
Jackson County, Oregon.

Survey Procedure: Found NW corner of East 1/2 D. L. C.
#49, T. 38 S., R. 2 W., W. M. Used
Dark Hollow Road, Crooked Creek and
previous survey for basis of control.
Set 5/8" steel pins, as shown on map.

Leland P. Lovejoy
Registered Land Surveyor

Work Completed April 14, 1961

