99262PM

11 25665



LARRY J. FRIAR JAMES E. HIBBS PHONE/FAX 541-772-2782

SISKIYOU SPRINGS LUXURY TOWNHOMES KEY MAP TO POST MONUMENTATION


PREPARED BY:

⊗ = SET BRASS TAG MKD. LS2234 IN LEAD PLUG IN CONCRETE.

L.J. FRIAR & ASSOCIATES, P.C. CONSULTING LAND SURVEYORS 816 WEST 8TH STREET MEDFORD, OR 97501 PH 772-2782

391E15AA TL 1100

⇒ = SET 5/8" X 24" IRON PIN W/ PLASTIC CAP MKD. L.J. FRIAR & ASSOC.
1" WITNESS MONUMENT UNLESS NOTED OTHERWISE.

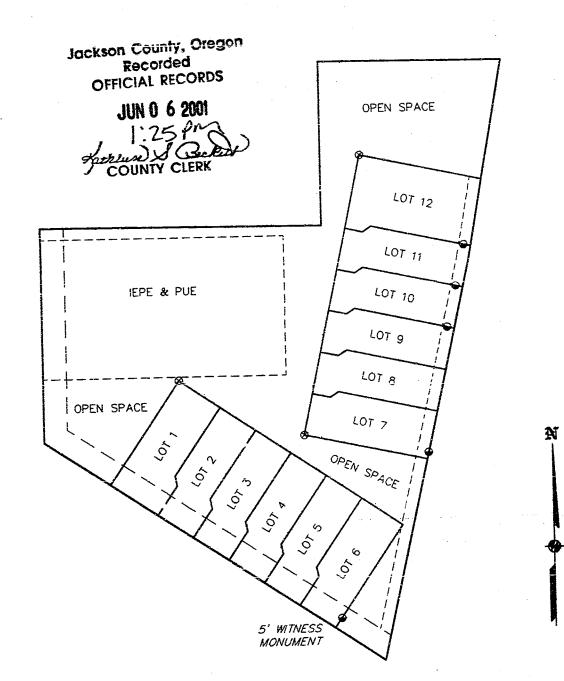

t.



L.J. FRIAR AND ASSOCIATES

CONSULTING LAND SURVEYORS

816 WEST 8TH STREET MEDFORD, OREGON 97501

LARRY J. FRIAR JAMES E. HIBBS

AFFIDAVIT OF MONUMENTATION FOR DEFERRED MONUMENTS Pursuant to O.R.S. 92.070

KNOW ALL MEN BY THESE PRESENTS, that I, James E. Hibbs, Registered Professional Land Surveyor of Oregon No. 2234, do hereby affirm that I have established with the proper monuments, the Street monuments and Subdivision corners shown as deferred on the Official Plat of SISKIYOU SPRINGS LUXURY TOWNHOMES filed as Survey No. 16757 in the Jackson County Surveyor's Office. The only differences from the monuments shown on the Official Plat are as shown on the attached Exhibit "A".

REGISTERED PROFESSIONAL LAND SURVEYOR

> OREGON JULY 17, 1986 JAMES E. HIBBS

RENEWAL DATE 6-30-01

STATE OF OREGON))ss COUNTY OF JACKSON)

Signed before me this $24^{\frac{7A}{2}}$ day of $\frac{MAY}{2}$ BY JAMES E. HIBBS

, 20 01.

Approved:

Ashland

Examined and approved this 6th day of _____

ckson County Surveyor

RECEIVED JUN 1 1 2001