

REGISTERED  
OREGON  
LAND SURVEYOR

*Leland P. Lovejoy*

NOVEMBER 18, 1949  
LELAND P. LOVEJOY  
262

BOUNDARY SURVEY OF PROPERTY  
 SITUATE IN  
 SE 1/4 OF SW 1/4 SEC. 3 & NE 1/4 OF NW 1/4 SEC. 10,  
 ALL IN T.36 S., R.3 W., W.M.  
 JACKSON COUNTY OREGON  
 FOR  
 BORDER MINES, INC.

L.P. LOVEJOY L.S. MEDFORD, ORE.  
 SCALE: 1" = 200' 5-10-61  
 BEARINGS BY SOLAR OBSERVATION.  
 ● = SET 1 1/4" G.I.P.


Survey Narrative to Comply with Section 87-3301947 Oregon State Laws

Survey for: Border Mines, Inc.  
c/o Mr. Bob Wells  
Medford Hotel  
Medford, Oregon


Purpose of Survey: To establish property boundaries of  
Garfield Iron Mine Lot #41 (Patented) in  
Sections 3 and 10, Township 36 South,  
Range 3 West, Willamette Meridian,  
Jackson County, Oregon.

Survey Location: Sections 3 and 10, Township 36 South,  
Range 3 West, Willamette Meridian,  
Jackson County, Oregon.

Survey Procedure: Found section corner monuments and  
bearing trees, as shown on map. Also  
found one bearing tree for 1/4 corner  
between Sections 3 and 10 and set 1 1/2"  
G. I. pipe for this corner and blazed  
one tree. Set 1 1/2" B. I. pipe for west  
1/16 corner, midway between quarter  
corner and section corner. Set 1 1/4"  
G. I. pipe for property corners, as shown  
on map.

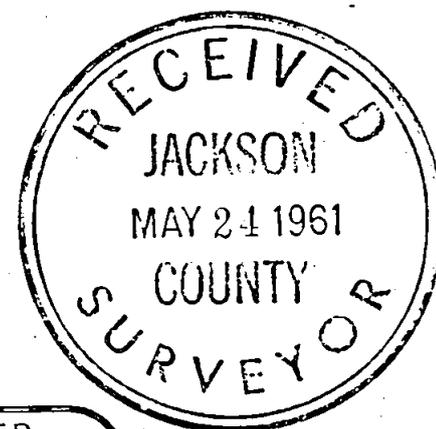

Leland P. Lovejoy  
Registered Land Surveyor  
Work completed May 10, 1961

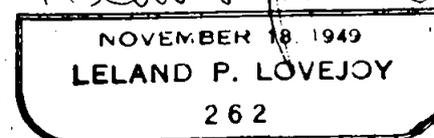

*Leland P. Lovejoy*