SURVEY FOR:
Charles Raper
922 Park Ave.
Medford, OR. 97501

SURVEY BY:
Kaiser Surveying
19440 Highway 62
Eagle Point, OR. 97524

LOCATION:
Lots 4, 5 & 6, Block 2 of TUTTLE'S FIRST ADD. and in the NE1/4 of Section 36, T.37S.,R.2W., W.M., City of Medford, Jackson County, Oregon

DATE:
June 26, 2001

SCALE: 1" = 50'

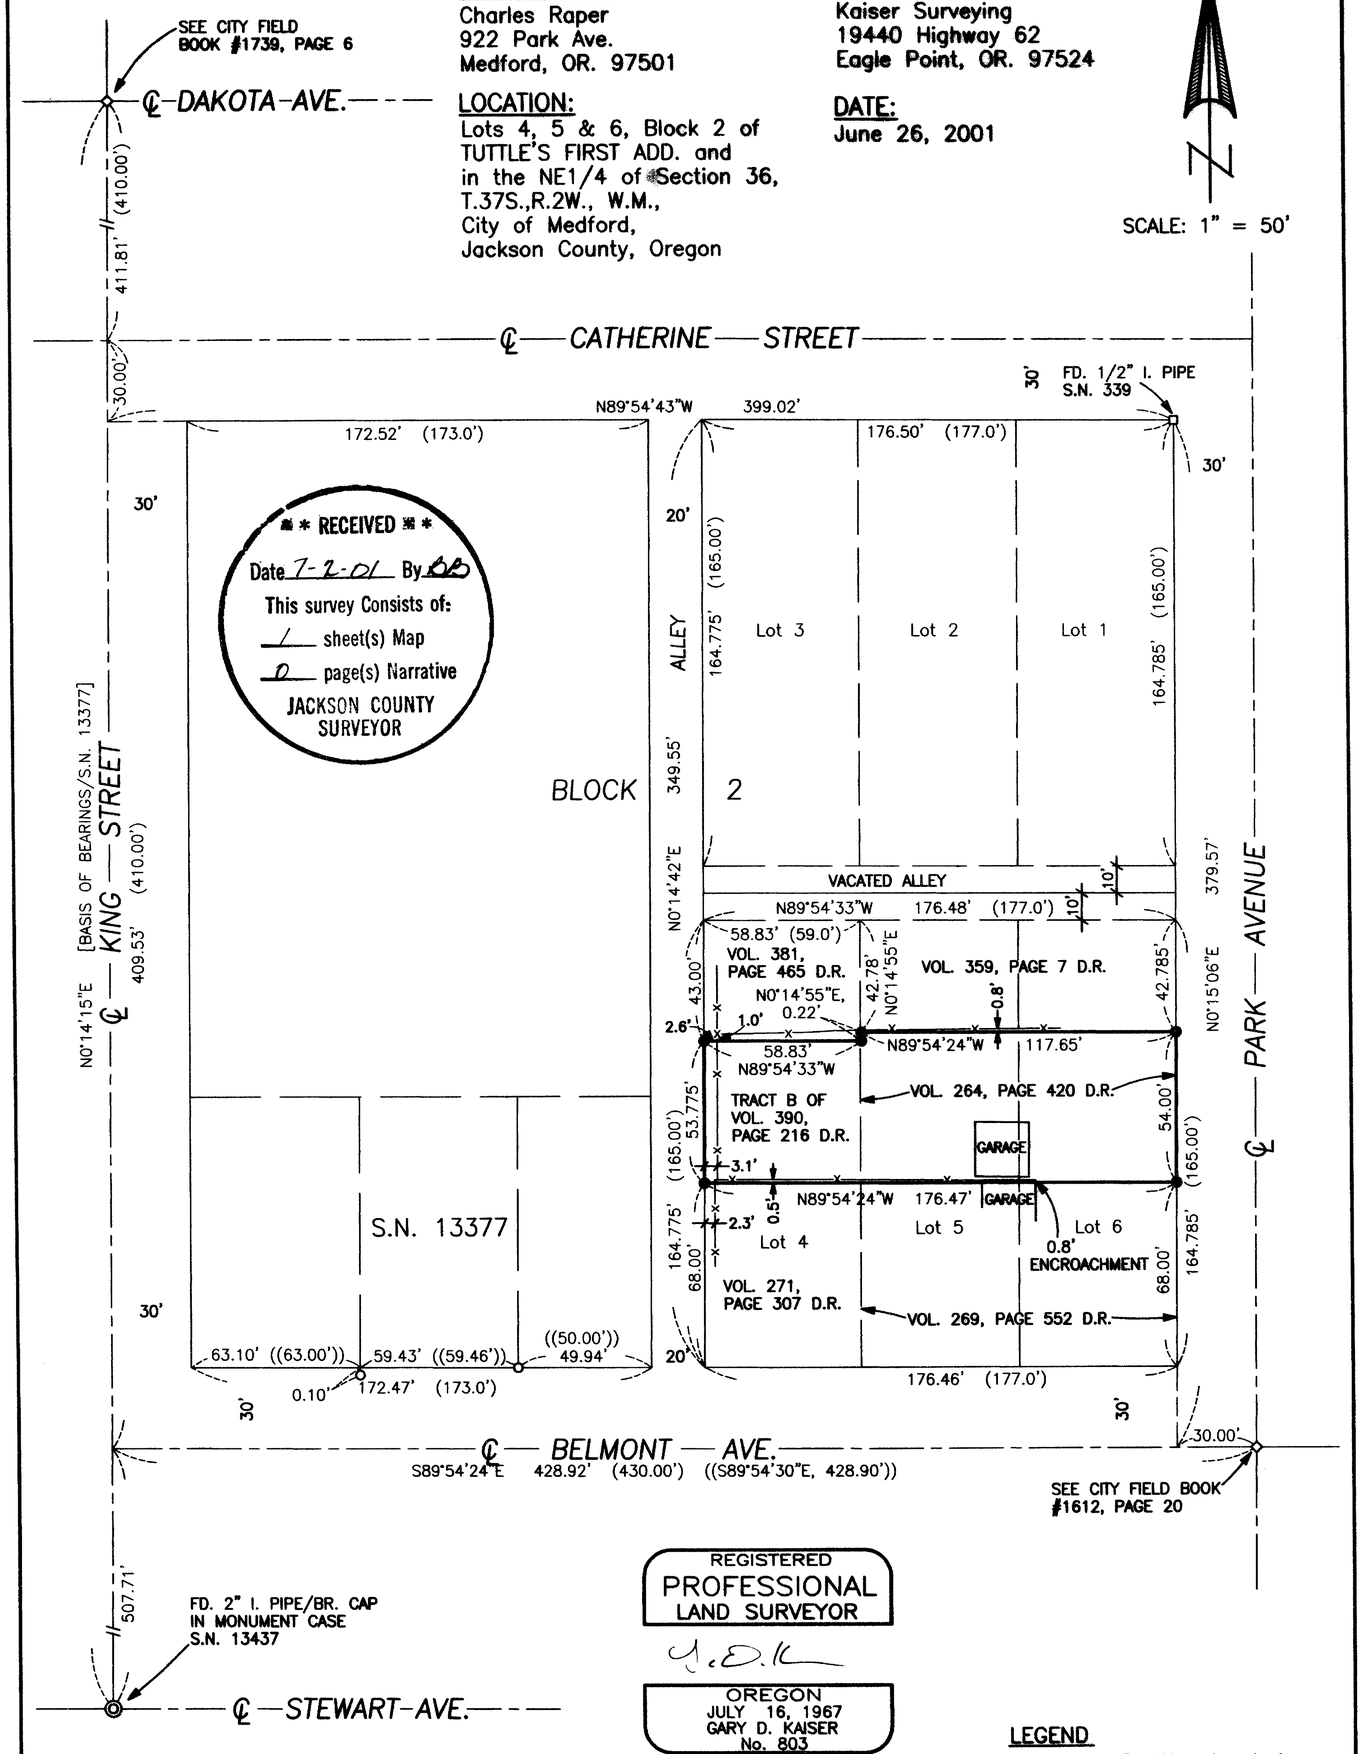

REGISTERED
PROFESSIONAL
LAND SURVEYOR

OREGON
JULY 16, 1967
GARY D. KAISER
No. 803
EXP. 6-30-01

LEGEND

◇ = Centerline Position located from City References

o = Found 5/8" Rebar with Plastic Cap – S.N. 13377

● = Set 5/8" x 24" Rebar with Plastic Cap marked "KAISER RLS 803"

S.N. = Filed Survey Number County Surveyors Office

( ) = Record/TUTTLE'S FIRST ADD.

(( )) = Record S.N. 13377

SURVEY NARRATIVE TO COMPLY WITH O.R.S. 209.250

PURPOSE: Boundary Survey of Tract described in Inst. No. 85-16215 O.R. The original deeds out for this property are Vol. 264, Page 420 D.R. and Vol. 390, Page 216 D.R.

PROCEDURE: The Block and Lot corners of Block 2, TUTTLE'S FIRST ADD. were computed from found monuments and information on Filed Survey Nos. 339 and 13377 as shown. The boundaries of the subject property were computed giving the senior deeds priority.

T.L. No. 372W 36AA – 7000