16996

MAP OF SURVEY
HAMRICK ROAD / WEST VILAS ROAD
(FROM BIDDLE ROAD - TO TABLE ROCK ROAD)
LOCATED IN THE N.W. 1/4 OF SEC. 1, T37S, R2W, W.M.
AND THE S.W. 1/4 OF SEC. 36, T36S, R2W, W.M.

SCALE: 1" = 100'

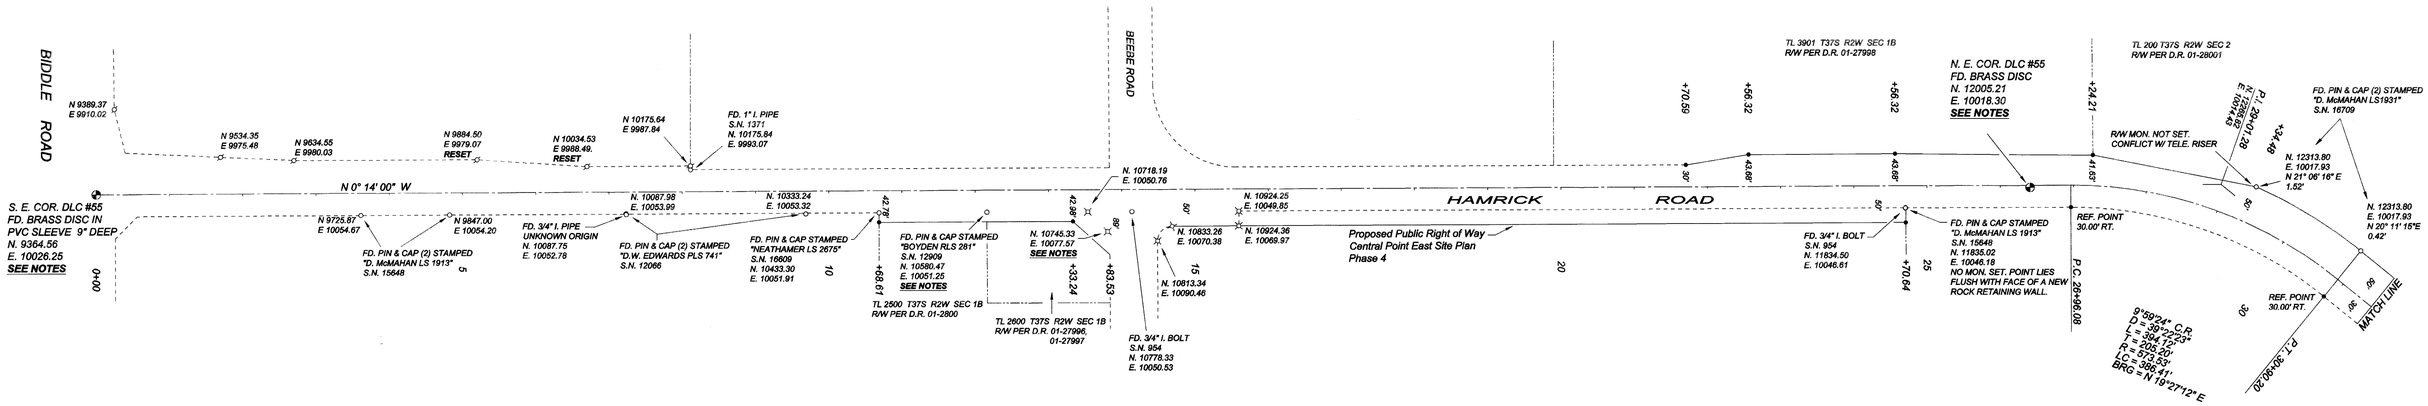

BASIS OF BEARINGS

EAST LINE DLC #55 N 00° 10' 20" W (S. N. 12909) MEAS. 2640.66'

S. E. COR. DLC #55 — N. E. COR. DLC #55

SURVEY NARRATIVE TO COMPLY WITH O.R.S. 209.150

SURVEY FOR: JACKSON COUNTY ROADS AND PARKS
200 ANTELOPE ROAD, WHITE CITY, OR. 97503
PURPOSE OF SURVEY: TO MONUMENT THE ROAD RIGHT OF WAY OWNED BY JACKSON COUNTY, OREGON
PROCEDURE: PRIOR TO A RECONSTRUCTION AND REALIGNMENT PROJECT, A CLOSED TRAVERSE WAS RUN TYING IN FOUND MONUMENTS AND GOVERNMENT CORNERS AS SHOWN. RIGHT OF WAY WAS ACQUIRED BY PETITION AND DEED. CO-ORDINATES ARE ASSUMED.
BASIS OF BEARINGS: THE EAST LINE OF DONATION LAND CLAIM # 55 AS SHOWN ON RECORDED SURVEY 12909.
DATE: JUNE 21, 2001

LEGEND

- GOVERNMENT CORNER AS NOTED
- ○ FOUND MONUMENT AS NOTED
- ● SET 5/8" X 24" I. PIN w/YELLOW PLASTIC CAP STAMPED "JACKSON CO. RDS & PKS SVC"
- △ FOUND PIN AND CAP STAMPED "FARBER LS 2189" RECORDED SURVEY NUMBER 15650
- ⊕ FOUND PIN AND CAP STAMPED "FARBER LS 2189" RECORDED SURVEY NUMBER 15891
- ⌀ FOUND PIN AND CAP STAMPED "RANDY L. FITCH LS 2867" RECORDED SURVEY NUMBER 16038
- ⌑ FOUND PIN AND CAP STAMPED "RANDY L. FITCH LS 2867" RECORDED SURVEY NUMBER 16026
- D.R. DEED RECORD
- S.N. RECORDED SURVEY NUMBER
- RIGHT OF WAY CENTERLINE

JACKSON COUNTY ROADS AND PARKS SERVICES
200 ANTELOPE ROAD
WHITE CITY, OREGON 97503

REGISTERED PROFESSIONAL LAND SURVEYOR
OREGON
JANUARY 17, 1995
JAMES P. DICKERSON
2691
EXP. 12-31-01

37 2W 1B

SCALE: 1" = 100'

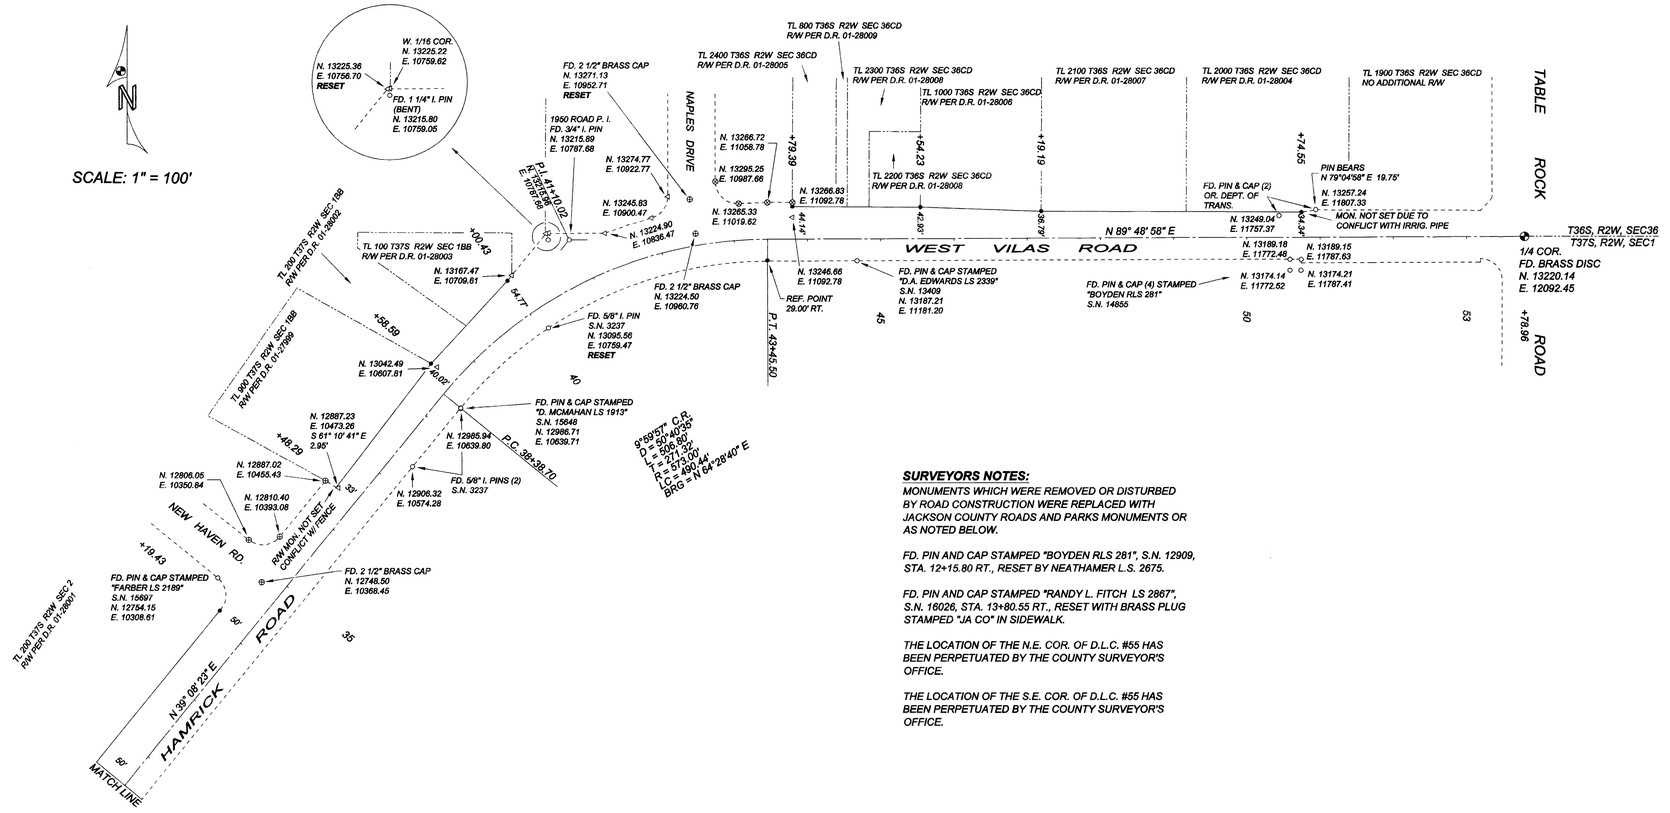

SURVEYORS NOTES:

MONUMENTS WHICH WERE REMOVED OR DISTURBED BY ROAD CONSTRUCTION WERE REPLACED WITH JACKSON COUNTY ROADS AND PARKS MONUMENTS OR AS NOTED BELOW.

FD. PIN AND CAP STAMPED "BOYDEN RLS 281", S.N. 12909, STA. 12+15.80 RT., RESET BY NEATHAMER L.S. 2675.

FD. PIN AND CAP STAMPED "RANDY L. FITCH LS 2867", S.N. 16026, STA. 13+80.55 RT., RESET WITH BRASS PLUG STAMPED "JA CO" IN SIDEWALK.

THE LOCATION OF THE N.E. COR. OF D.L.C. #55 HAS BEEN PERPETUATED BY THE COUNTY SURVEYOR'S OFFICE.

THE LOCATION OF THE S.E. COR. OF D.L.C. #55 HAS BEEN PERPETUATED BY THE COUNTY SURVEYOR'S OFFICE.

** RECEIVED **
Date 7-17-01 By
This survey consists of
1 sheet(s) Map
2 page(s) Narrative
JACKSON COUNTY SURVEYOR

16996