

**LEGEND**

- Indicates a found 1 inch diameter rebar unless noted. Refer to S/N 5171.
- Indicates set 5/8" x 30" iron rod with a yellow plastic cap marked "Land Mark".
- 33 34  
4 3  
Indicates a found brass cap atop an iron pipe, marking the southwest corner of Section 34. Per Jackson County Renewal.
- X - Indicates Fence Line
- RECORD INFORMATION  
 ( ) Per S/N 5171

**Survey Narrative to comply with O.R.S. 209.250**



The purpose of this survey is to monument the boundary of a Communications Lease Area.

U.S.G.S Control monuments were used to establish the location of the site. Sufficient property corners were tied to protract the lessors property and monuments were set as shown.

**BASIS FOR SURVEY:**

Basis of bearings are referenced to TRUE NORTH, as derived from Global Positioning System observations at the NATIONAL GEODETIC SURVEY station "PINKHAM"; a found 4-inch diameter brass cap marked "PINKHAM 1991". Published NAD 83 (1991) Datum: Latitude = 42°29'36.93059" N; Longitude = 122°49'48.95456" W; with a convergence angle of -1°35'39.3", and a scale factor of 0.99996350.

Published NAVD 88 elevation at station "N 8", a Oregon State Highway Department brass disk set in North end of the east headwall of an irrigation culvert, marked "N 8 1930". : 1306.79 feet.

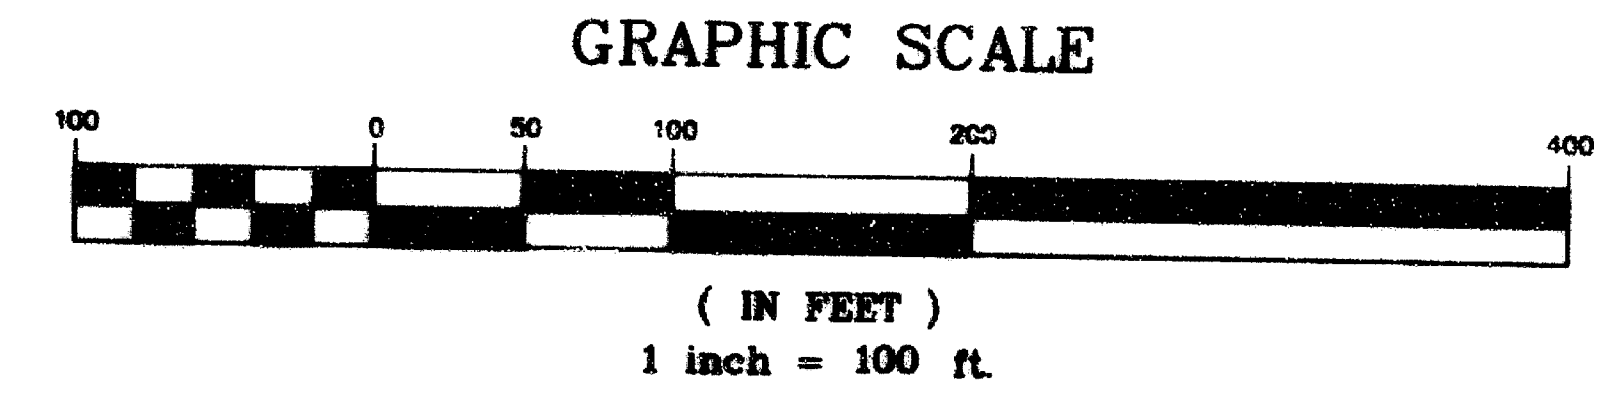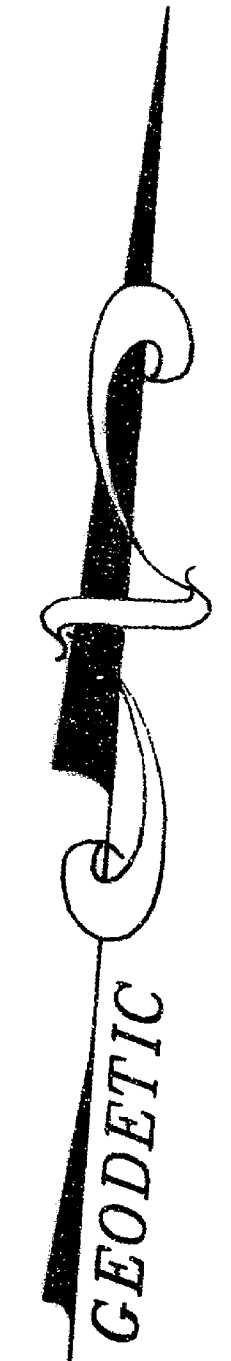

Sheet 1 of 1

**RECORD OF SURVEY**  
 In the SW 1/4, Section 34  
 Township 35 South, Range 1 West, W.M.  
 Jackson County, Oregon  
 September, 2001

FOR: Mericom Corporation  
 25977 S.W. Canyon Creek Rd.  
 Wilsonville, OR. 97070

**REGISTERED PROFESSIONAL LAND SURVEYOR**  
 Mark A. Heimbürger  
 OREGON  
 JULY 16, 1987  
 MARK A. HEIMBURGER  
 2287

**Land Mark SURVEYING INC.**  
 3329 N.E. Stephens Street  
 Roseburg, Oregon 97470  
 Tel (541) 677-9400  
 Fax (541) 677-9401

RENEWS 06/30/2003 LM Proj. No. 2001-0070

**\*\* RECEIVED \*\***  
 Date 9-17-01 By [Signature]  
 This survey consists of:  
 1 sheet(s) Map  
 2 page(s) Narrative  
 JACKSON COUNTY SURVEYOR

35 to 34